City of Prince George
HISTORY SHEET

SHEET NUMBER **Roll Number** 018578071

Legal: LOT'S 4 (OF LOT 16) BLOCK D.L. 754 PLAN 37728

Address: 2614 BERNARD RD.

Sanitary Connection: # SIZE 100 mm MATERIAL P.V.C. INV. CONNECTED

Water Connection # SIZE 20 mm MATERIAL Co. METER CONNECTED

Storm Connection: # SIZE 100 mm MATERIAL P.V.C. INV. CONNECTED

Cash Receipt No's: WATER 12234 SANITARY 12234 STORM 12234

CURB FROM PROPERTY LINE NO CURB PAVEMENT WIDTH 10.000 m

B.C. HYDRO O/H UNDERGROUND CONNECTION

B.C. TELEPHONE O/H UNDERGROUND CONNECTION

INLAND GAS

Information Sheets:

Comments: Aug 93 - Comp conn
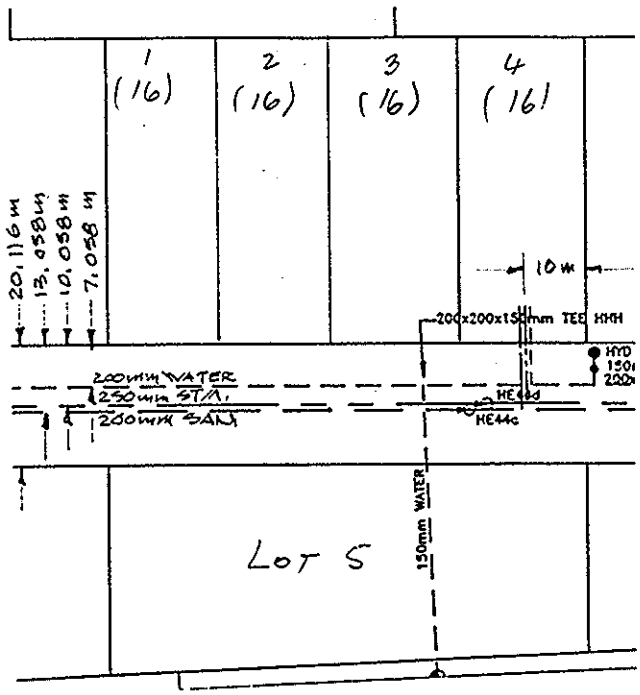
THE INFORMATION CONTAINED HEREIN IS FOR INTERNAL USE ONLY.
NOT TO BE RELIED UPON UNLESS CONFIRMED BY SITE INSPECTION AND/OR INVESTIGATION