City of Prince George
HISTORY SHEET

SHEET NUMBER **Roll Number** 0188A460

Legal: LOT'S B (OF LOT 29) BLOCK D.L. 754 PLAN 38077

Address: 2767 PARENT RD.

Sanitary Connection: # SIZE 100MM MATERIAL PVC INV. CONNECTED

Water Connection # SIZE 20MM MATERIAL Copper METER CONNECTED

Storm Connection: # SIZE 100MM MATERIAL PVC INV. CONNECTED

Cash Receipt No's: WATER 11374 SANITARY 11374 STORM 11374

CURB FROM PROPERTY LINE NO CURB PAVEMENT WIDTH 10.000m

B.C. HYDRO O/H UNDERGROUND CONNECTION

B.C. TELEPHONE O/H UNDERGROUND CONNECTION

INLAND GAS AS SHOWN

Information Sheets:

Comments:
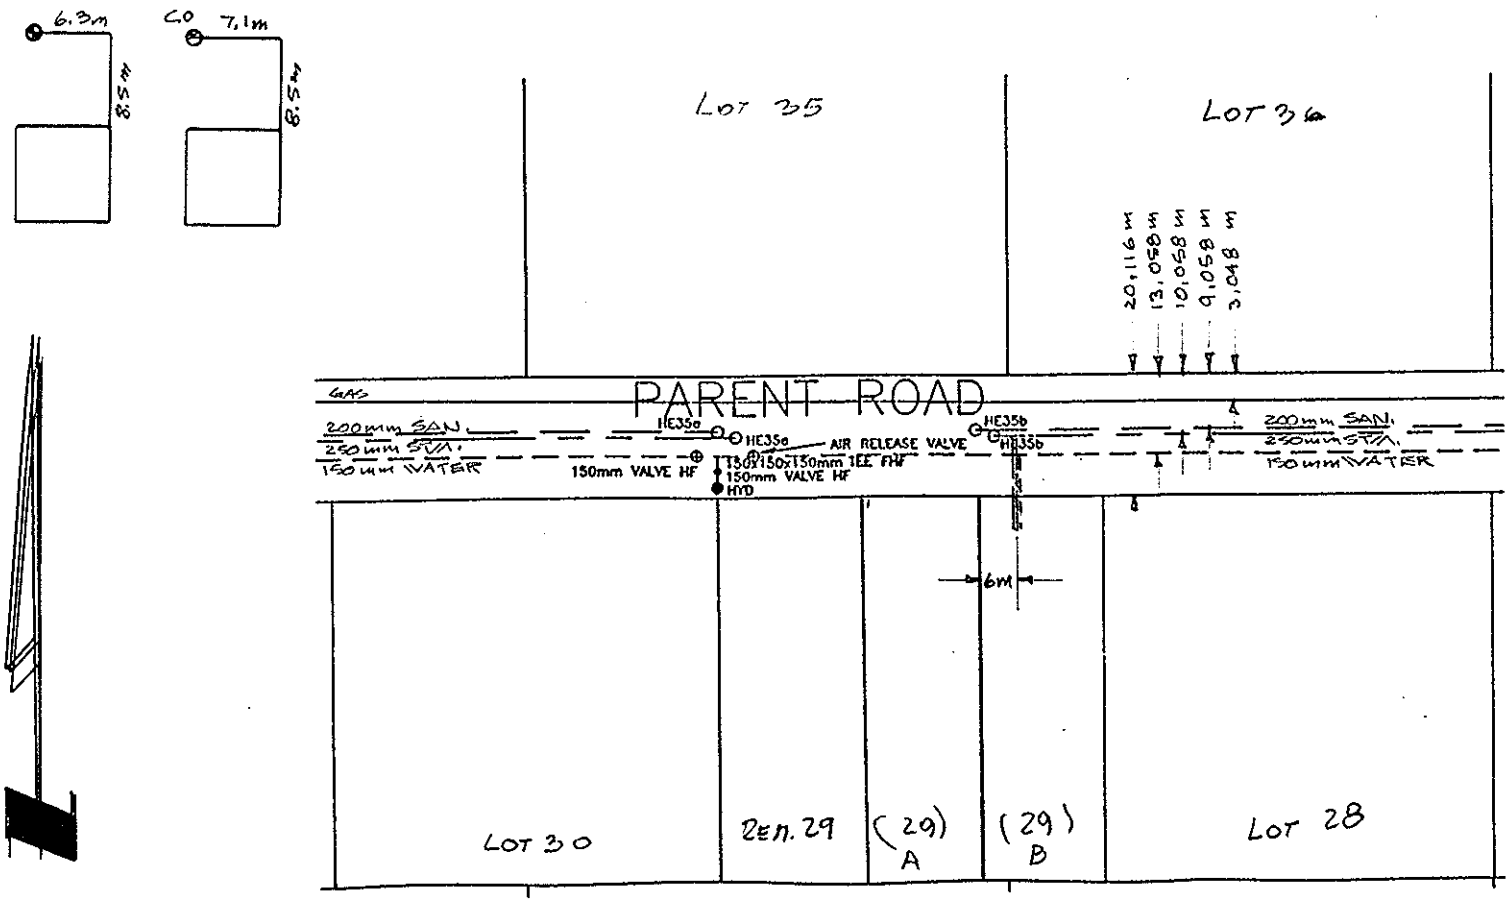
THE INFORMATION CONTAINED HEREIN IS FOR INTERNAL USE ONLY.
NOT TO BE RELIED UPON UNLESS CONFIRMED BY SITE INSPECTION AND/OR INVESTIGATION