City of Prince George
HISTORY SHEET

SHEET NUMBER

Roll Number [illegible]

Legal: LOT'S A BLOCK D.L. 2424 PLAN 38195

Address: 4716 HANDLEN RD.

Sanitary Connection: # SIZE 100mm MATERIAL PVC INV. CONNECTED

Water Connection # SIZE 20mm MATERIAL Cu METER CONNECTED

Storm Connection: # SIZE 100mm MATERIAL P.V.C. INV. 758.988 CONNECTED YES

Cash Receipt No's: WATER 14334 SANITARY 14334 STORM

CURB FROM PROPERTY LINE 3.558 PAVEMENT WIDTH 13.0 m

B.C. HYDRO O/H UNDERGROUND CONNECTION

B.C. TELEPHONE O/H UNDERGROUND CONNECTION

INLAND GAS AS SHOWN

Information Sheets:

Comments:
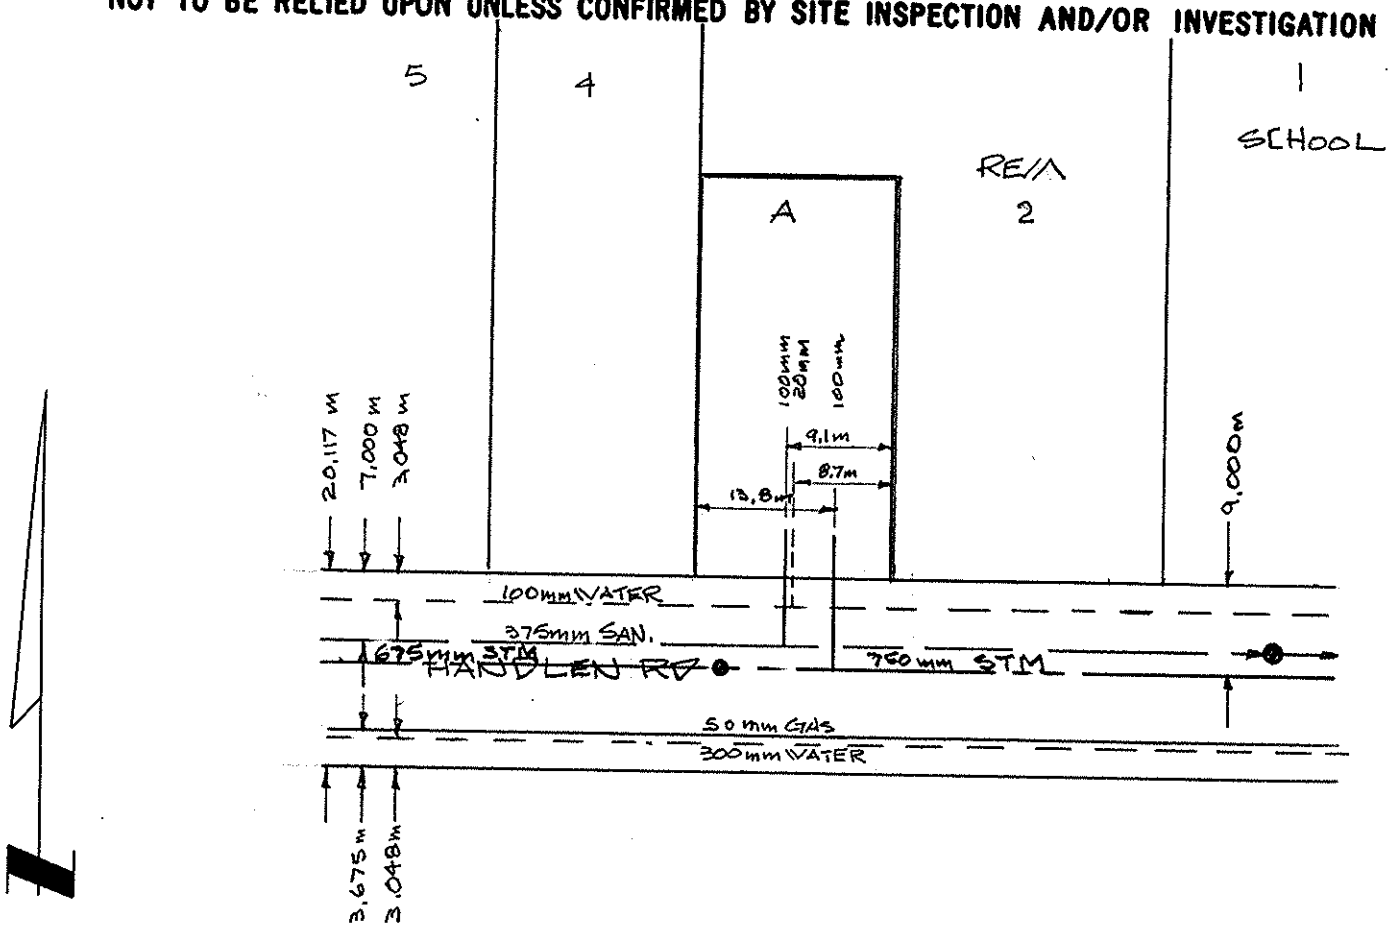
THE INFORMATION CONTAINED HEREIN IS FOR INTERNAL USE ONLY.
NOT TO BE RELIED UPON UNLESS CONFIRMED BY SITE INSPECTION AND/OR INVESTIGATION