City of Prince George
HISTORY SHEET

SHEET NUMBER **Roll Number** 018910211

Legal: LOT'S 3 BLOCK D.L. 2003 PLAN 38248

Address: 6413 ST ANTHONY CRES

Sanitary Connection: # SIZE 100 MATERIAL PVC INV. 657.11 CONNECTED

Water Connection # SIZE 20 MATERIAL Cu METER CONNECTED

Storm Connection: # SIZE 100 MATERIAL PVC INV. 657.13 CONNECTED

Cash Receipt No's: WATER SANITARY STORM

CURB FROM PROPERTY LINE 5.0m PAVEMENT WIDTH 10.0m

B.C. HYDRO U/G 1.33m from East P.L. UNDERGROUND CONNECTION

B.C. TELEPHONE U/G 1.33m from East P.L. UNDERGROUND CONNECTION

INLAND GAS

Information Sheets:

Comments:
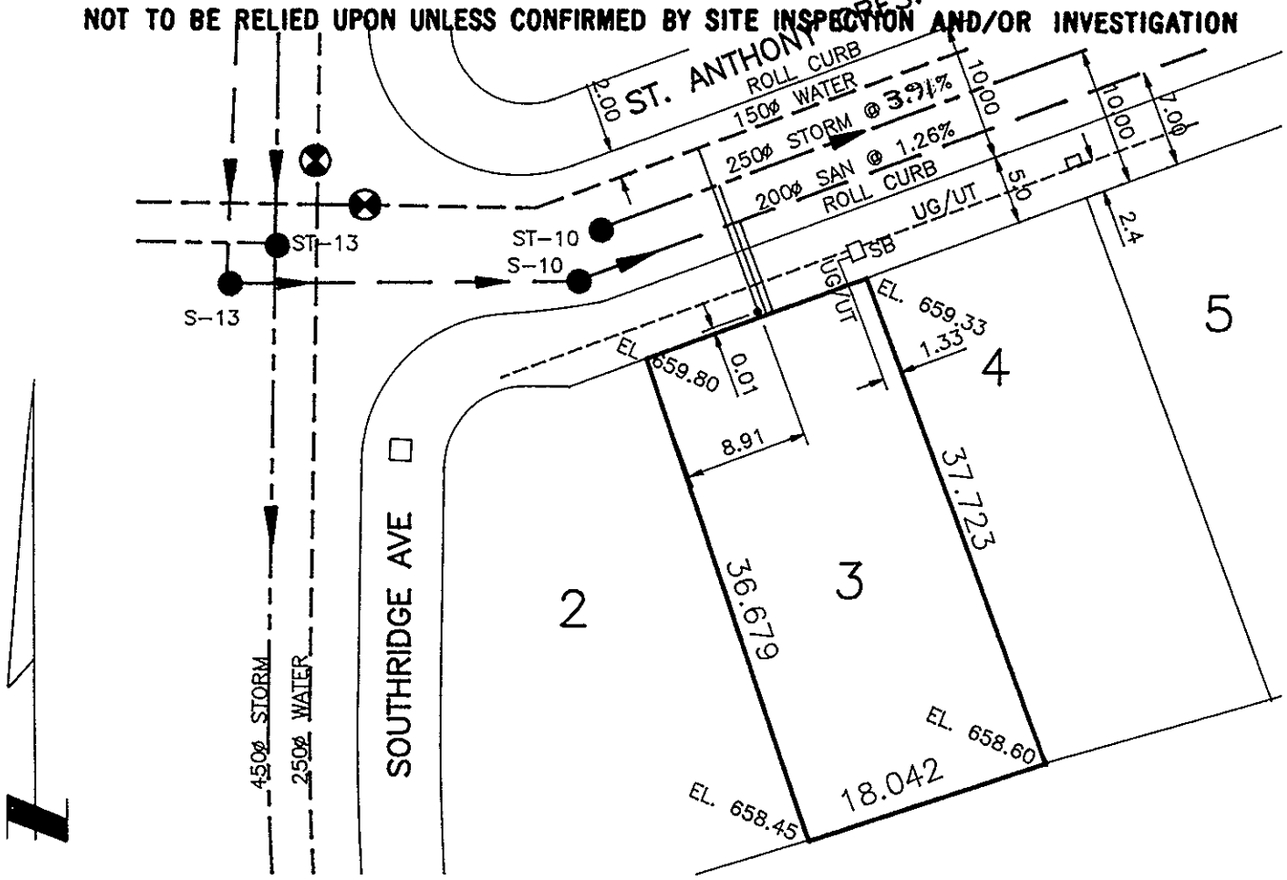
THE INFORMATION CONTAINED HEREIN IS FOR INTERNAL USE ONLY.
NOT TO BE RELIED UPON UNLESS CONFIRMED BY SITE INSPECTION AND/OR INVESTIGATION