City of Prince George
HISTORY SHEET

C060-94

SHEET NUMBER

Roll Number 019129254

Legal: LOT'S 2 BLOCK D.L. 754 PLAN 38594

Address: 2650 MARLEAU RD.

Sanitary Connection: # SIZE 100mm MATERIAL P.V.C INV. CONNECTED

Water Connection # SIZE 20 mm MATERIAL CU. METER CONNECTED

Storm Connection: # SIZE 100 mm MATERIAL P.V.C. INV. CONNECTED

Cash Receipt No's: WATER 11312 SANITARY 11312 STORM 11312

CURB FROM PROPERTY LINE NO CURB PAVEMENT WIDTH 10.000 m

B.C. HYDRO O/H UNDERGROUND CONNECTION

B.C. TELEPHONE O/H UNDERGROUND CONNECTION

INLAND GAS

Information Sheets:

Comments:

THE INFORMATION CONTAINED HEREIN IS FOR INTERNAL USE ONLY.
NOT TO BE RELIED UPON UNLESS CONFIRMED BY SITE INSPECTION AND/OR INVESTIGATION
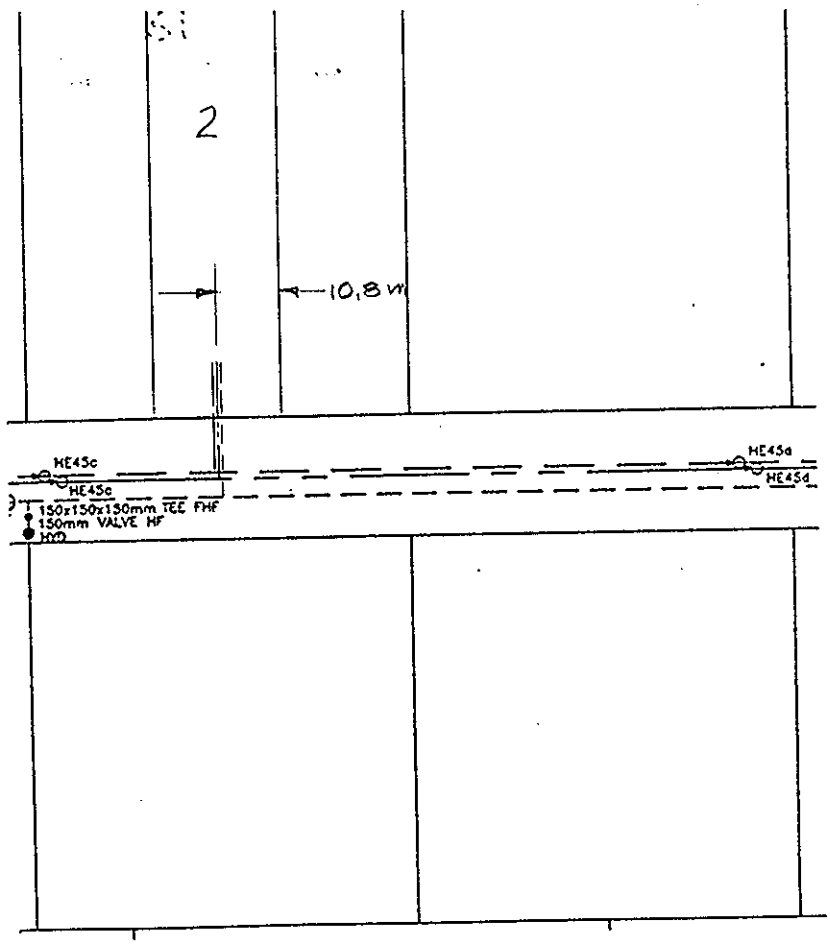
MARLEAU RD.