City of Prince George
HISTORY SHEET

#047/95

SHEET NUMBER

Roll Number 023265060

Legal: LOT'S 7 BLOCK D.L. 4039 PLAN 39527

Address: 5478 LEHMAN ST.

Sanitary Connection: # SIZE 100 mm MATERIAL P.V.C. INV. CONNECTED

Water Connection # SIZE 20 mm MATERIAL CU. METER CONNECTED

Storm Connection: # SIZE MATERIAL INV. CONNECTED

Cash Receipt No's: WATER 15100 SANITARY 15100 STORM

CURB FROM PROPERTY LINE PAVEMENT WIDTH

B.C. HYDRO O/H UNDERGROUND CONNECTION

B.C. TELEPHONE O/H UNDERGROUND CONNECTION

INLAND GAS AS SHOWN

Information Sheets:

Comments: web drawing
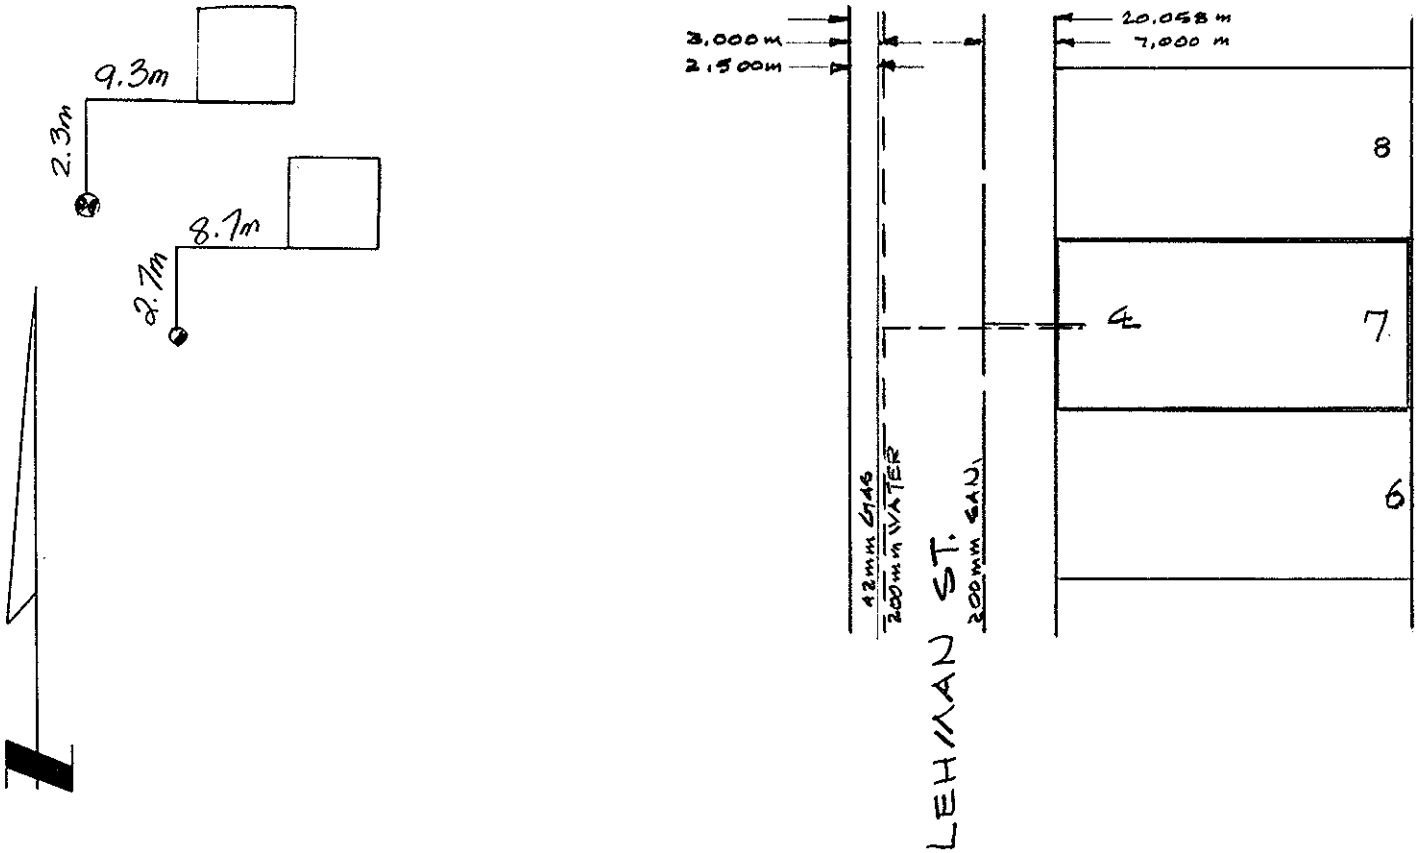
THE INFORMATION CONTAINED HEREIN IS FOR INTERNAL USE ONLY.
NOT TO BE RELIED UPON UNLESS CONFIRMED BY SITE INSPECTION AND/OR INVESTIGATION