City of Prince George
HISTORY SHEET

SHEET NUMBER **Roll Number** 023494051

Legal: LOT'S 23 BLOCK D.L. 2425 PLAN 40290

Address: 5410 Woodoak Crescent

Sanitary Connection: # SIZE 100 mm MATERIAL PVC INV. 763.317 m CONNECTED

Water Connection # SIZE 20 mm MATERIAL Copper METER CONNECTED

Storm Connection: # SIZE 100 mm MATERIAL PVC INV. 763.317 m CONNECTED

Cash Receipt No's: WATER SANITARY STORM

CURB FROM PROPERTY LINE 5 m PAVEMENT WIDTH 10 m

B.C. HYDRO U/G 1.0 m UNDERGROUND CONNECTION from West P.L.

B.C. TELEPHONE U/G 1.0 m UNDERGROUND CONNECTION from West P.L.

INLAND GAS

Information Sheets:

Comments:
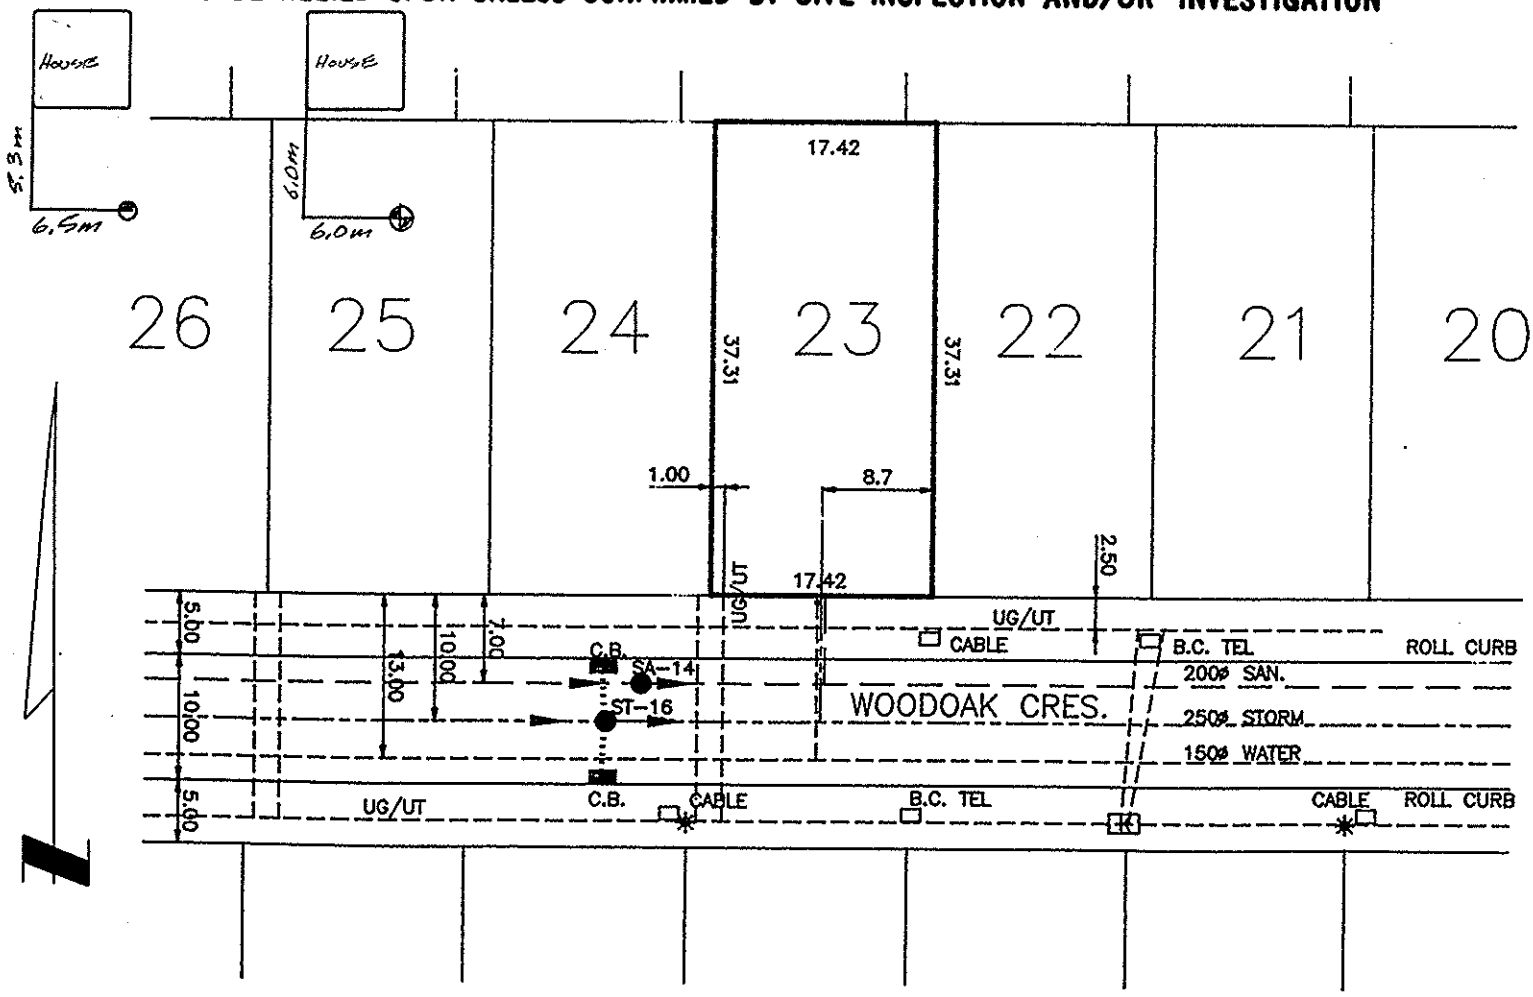
THE INFORMATION CONTAINED HEREIN IS FOR INTERNAL USE ONLY.
NOT TO BE RELIED UPON UNLESS CONFIRMED BY SITE INSPECTION AND/OR INVESTIGATION