Subdivided by Plan EPP33297 - Update required - see MU101417. History sheet update requested Nov 12, 2013 - Call 266620 and 266623.

96 P 79

City of Prince George
HISTORY SHEET

SHEET NUMBER **Roll Number** 08349 6621

Legal: LOT'S PCL 1 BLOCK D.L. 937 PLAN 40314

Address: 770 CENTRAL ST.

Sanitary Connection: # 5987, 9634, 9632, 9633 SIZE 100mm 100 mm MATERIAL PVC AC. INV. - 19026 CONNECTED

Water Connection # 970, 974, 969, 971 SIZE 150 mm 13 mm MATERIAL Cu LU METER - 19026 CONNECTED

Storm Connection: # SIZE 250mm MATERIAL INV. CONNECTED

Cash Receipt No's: WATER 19026 SANITARY 19026 3252, 188 STORM 19026

CURB FROM PROPERTY LINE 4.877 m PAVEMENT WIDTH 10.363 m

B.C. HYDRO O/H

B.C. TELEPHONE O/H

INLAND GAS AS SHOWN

Information Sheets:

Comments: 8.9 m W OF SW. CORNER S%

WKS2061 WORK ORDER 1996

CONNECTION AS BUILT (UNDERGROUND) MAINTENANCE

Work Order # : 1996-P0079

Installation Addr. : 770 CENTRAL ST

SANITARY SEWER
Field Surveyor : Surveyor Book # :
Connection Size : 150MM Material Type :
O/S From P.L. : 35M NORTH OF SOUTH P/L

WATER
Field Surveyor : Surveyor Book # :
Connection Size : 100MM Material Type :
O/S From P.L. : 35M NORTH OF SOUTH P/L

STORM SEWER
Field Surveyor : Surveyor Book # :
Connection Size : 250MM Material Type :
O/S From P.L. : GOES UP LANE OFF 8TH AVE SEE L & M DRW

Line	Action	Date	Comment
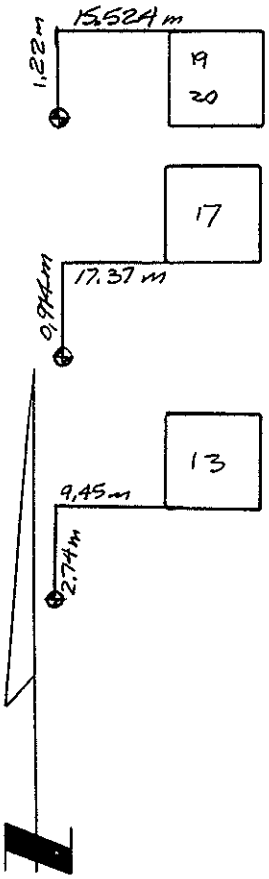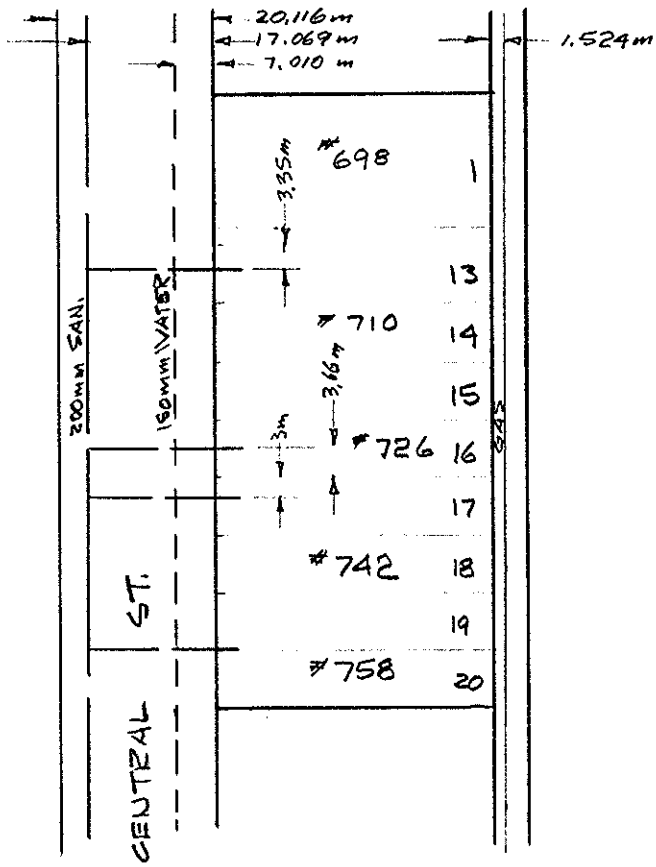
THE INFORMATION CONTAINED HEREIN IS FOR INTERNAL USE ONLY.
NOT TO BE RELIED UPON UNLESS CONFIRMED BY SITE INSPECTION AND/OR INVESTIGATION