S

City of Prince George
HISTORY SHEET

023517573

SHEET NUMBER № 1157 **Roll Num** 0

Legal: LOT'S PCL C BLOCK 32 D.L. 937 PLAN 152

Address: 512 EWERT ST

Sanitary Connection: # 2810 SIZE 100 mm 100mm MATERIAL PVC INV. 1.2m CONNECTED

Water Connection # 1750 SIZE 20 mm 19mm MATERIAL CU METER CONNECTED

Storm Connection: # SIZE MATERIAL INV. CONNECTED

Cash Receipt No's: WATER 119121 SANITARY 19121 55 (NON CASH) STORM

CURB FROM PROPERTY LINE 4.877m PAVEMENT WIDTH

B.C. HYDRO OVERHEAD UNDERGROUND CONNECTION

B.C. TELEPHONE O/H UNDERGROUND CONNECTION

INLAND GAS AS SHOWN

Information Sheets:

Comments: THE INFORMATION CONTAINED HEREIN IS FOR INTERNAL USE ONLY. NOT TO BE RELIED UPON UNLESS CONFIRMED BY SITE INSPECTION AND/OR INVESTIGATION.
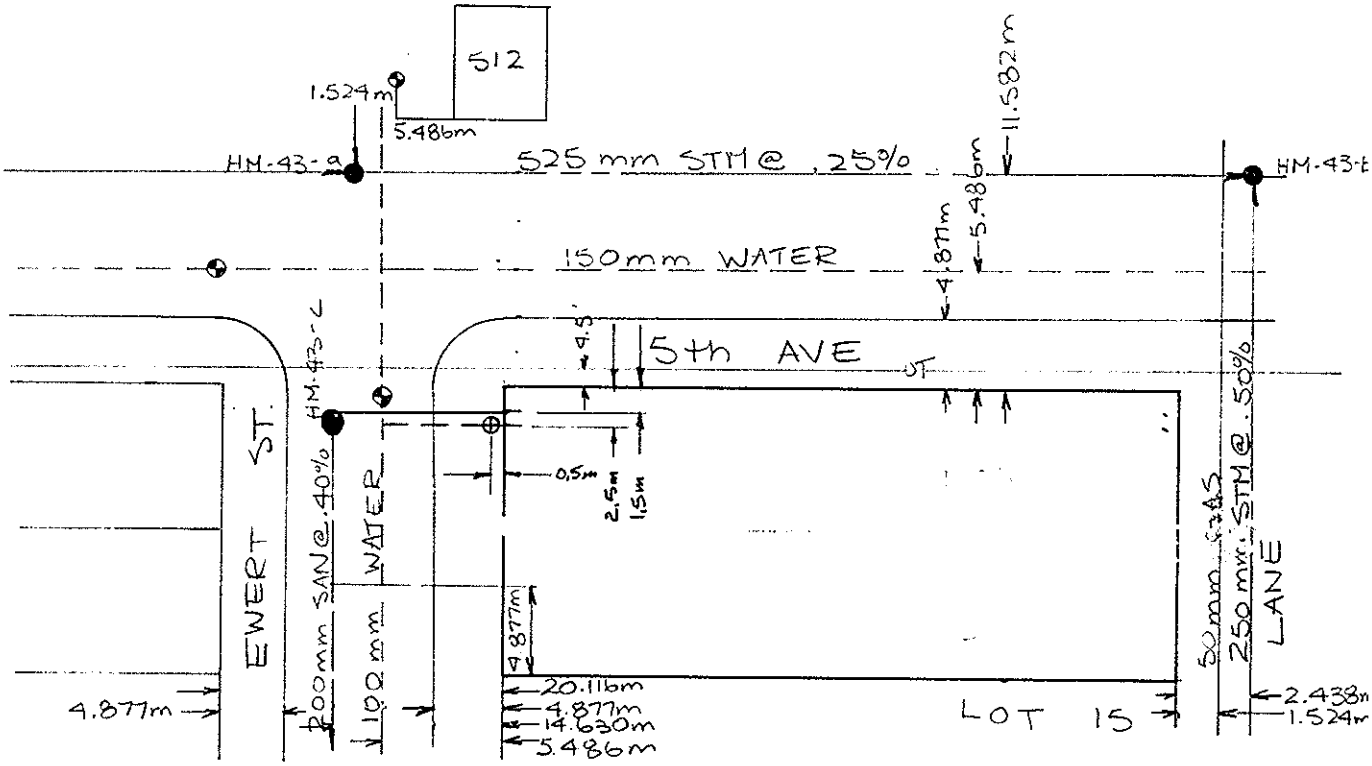
SITE PLAN N.T.S.