City of Prince George
HISTORY SHEET

SHEET NUMBER ROLL NUMBER 023557869

Legal: LOT 16 BLOCK D.L. 2432 PLAN 40491

Address: 9232 TWINBERRY DRIVE

Sanitary Connection:# SIZE: 100mmø MATERIAL: P.V.C. INV. 730.75 CONNECTED

Water Connection:# SIZE: 19mmø COPPER METER

Storm Connection:# SIZE: 100mmø MATERIAL: P.V.C. INV. 730.72 CONNECTED

Cash Receipt No's: WATER SANITARY STORM

CURB FROM PROPERTY LINE: 5m PAVEMENT WIDTH: 10m

B.C. HYDRO 0.4m U/G CONNECTION

B.C. TELEPHONE 1.05m U/G CONNECTION

B.C. GAS

Information Sheets:

Comments:
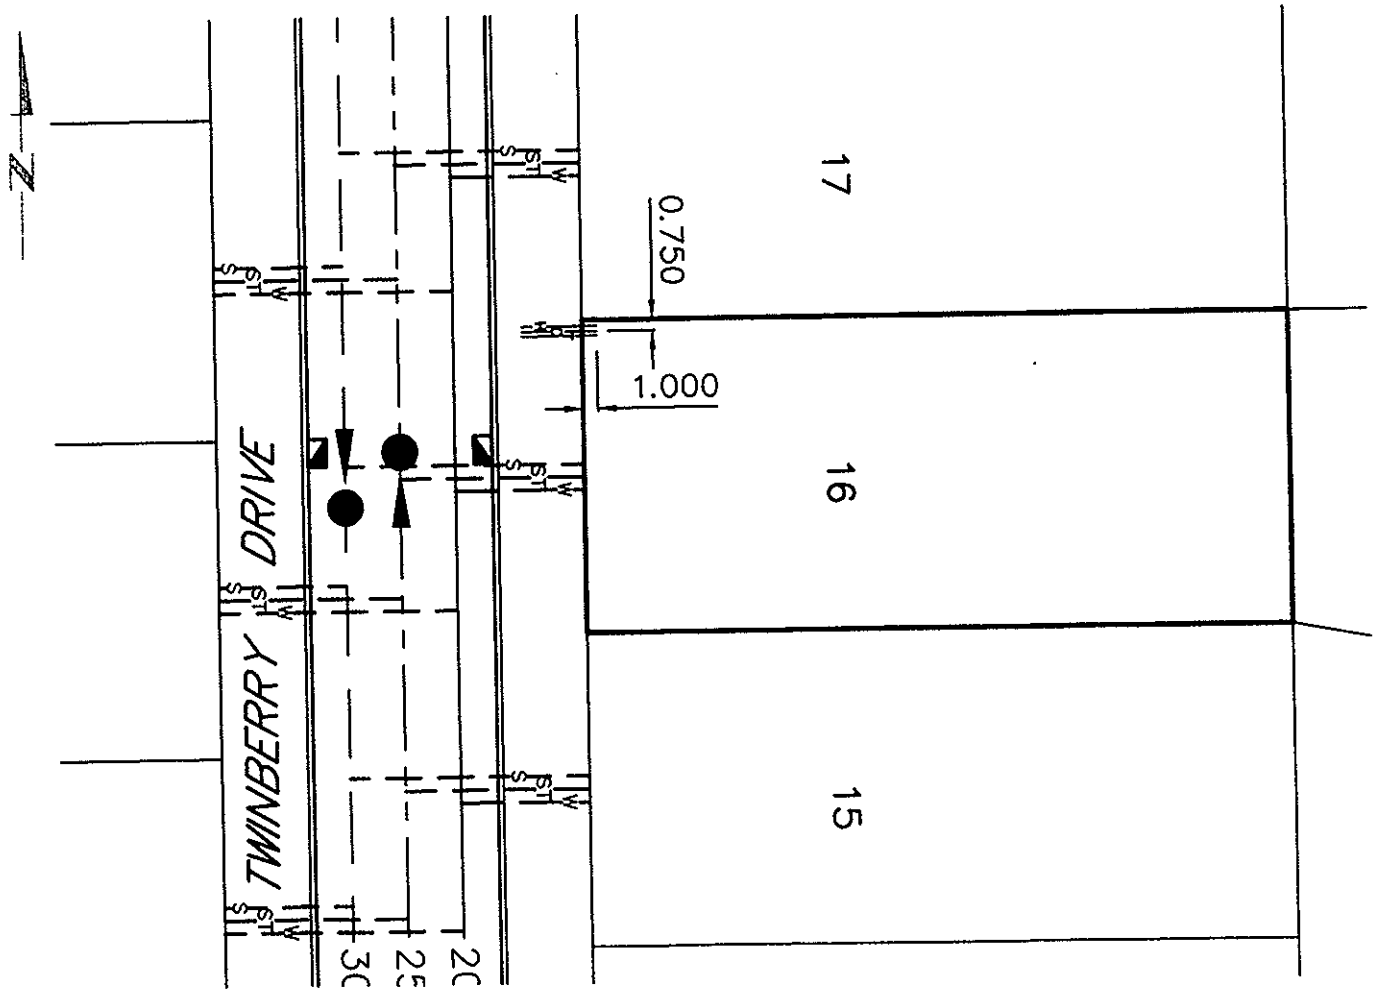
THE INFORMATION CONTAINED HEREIN IS FOR INTERNAL USE ONLY.
NOT TO BE RELIED UPON UNLESS CONFIRMED BY THE SITE INSPECTION AND/OR INVESTIGATION