City of Prince George
HISTORY SHEET

SHEET NUMBER **Roll Number** 024019933

Legal: LOT'S 1 BLOCK D.L. 1599 PLAN PGP42018

Address: 4488 HIGHWAY 16 WEST

Sanitary Connection: SIZE WEST 150mm EAST 200mm MATERIAL PVC INV. WEST 744.25m EAST 744.13m CONNECTED Y

Water Connection: SIZE WEST 100mm EAST 100mm MATERIAL PVC METER CONNECTED Y

Storm Connection: N/A SIZE N/A MATERIAL N/A INV. N/A CONNECTED N/A

Cash Receipt No's: WATER SANITARY STORM

CURB FROM PROPERTY LINE N/A PAVEMENT WIDTH 8.0 m

B.C. HYDRO N/A UNDERGROUND CONNECTION

B.C. TELEPHONE N/A UNDERGROUND CONNECTION

INLAND GAS N/A

Information Sheets:

Comments:
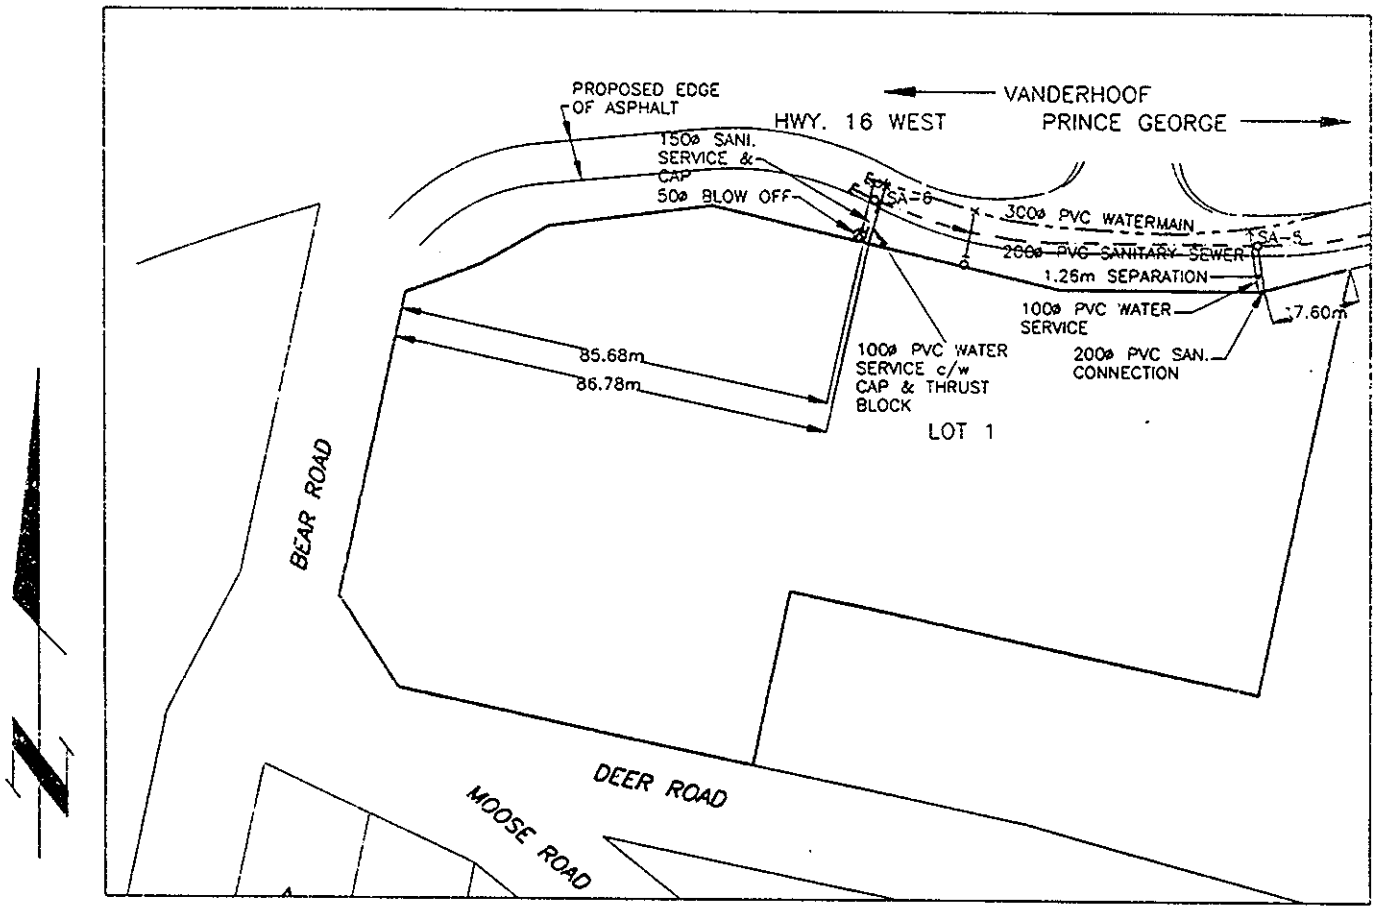
THE INFORMATION CONTAINED HEREIN IS FOR INTERNAL USE ONLY.
NOT TO BE RELIED UPON UNLESS CONFIRMED BY SITE INSPECTION AND/OR INVESTIGATION