City of Prince George
HISTORY SHEET

SHEET NUMBER **PID #** 024323705

Legal: LOT'S B BLOCK D.L. 2424 PLAN 43 247

Address: 8608 PETER ROAD

Sanitary Connection: # SIZE 100 mm MATERIAL P.V.C. INV. CONNECTED

Water Connection: # SIZE 20 mm MATERIAL CU. METER CONNECTED

Storm Connection: # SIZE mm MATERIAL INV. CONNECTED

Cash Receipt No's: WATER 22553 SANITARY 22553 STORM

CURB FROM PROPERTY LINE PAVEMENT WIDTH

B.C. HYDRO O/H UNDERGROUND CONNECTION

B.C. TELEPHONE O/H UNDERGROUND CONNECTION

INLAND GAS 3.048 m FROM PL.

Information Sheets:

Comments:
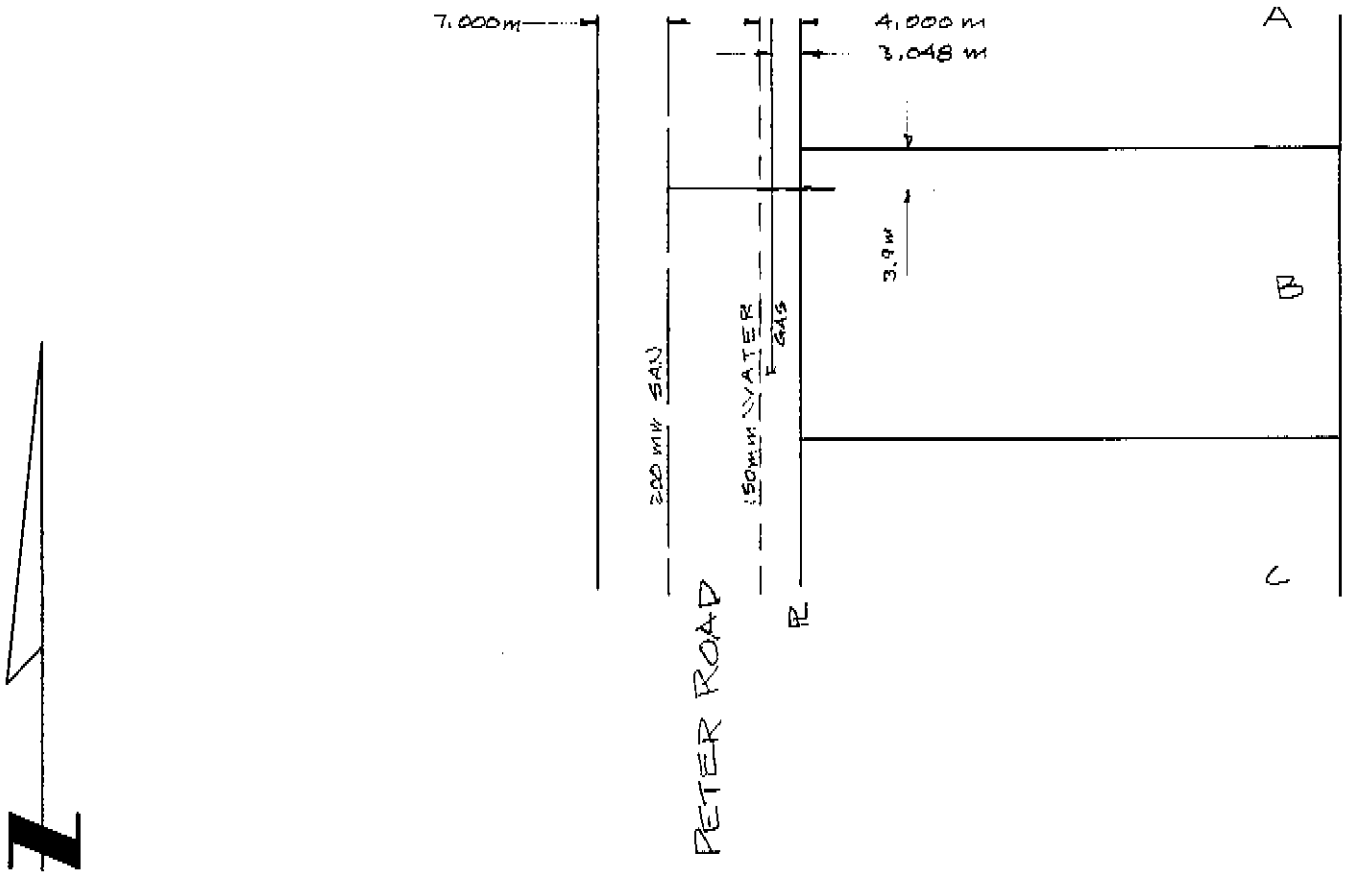
THE INFORMATION CONTAINED HEREIN IS FOR INTERNAL USE ONLY.
NOT TO BE RELIED UPON UNLESS CONFIRMED BY SITE INSPECTION AND/OR INVESTIGATION