City of Prince George
HISTORY SHEET

SHEET NUMBER 3228 Roll Number 02458.345

Legal: LOT'S 2 BLOCK D.L. 954 PLAN 44557

Address: 559 North Blackburn Road

Sanitary Connection: # SIZE 100mm MATERIAL PVC INV. CONNECTED

Water Connection # SIZE 20mm MATERIAL Cu METER CONNECTED

Storm Connection: # SIZE MATERIAL INV. CONNECTED

Cash Receipt No's: WATER 16634 SANITARY 16634 STORM

CURB FROM PROPERTY LINE PAVEMENT WIDTH

B.C. HYDRO O/H UNDERGROUND CONNECTION

B.C. TELEPHONE O/H UNDERGROUND CONNECTION

INLAND GAS AS SHOWN

Information Sheets:

Comments:
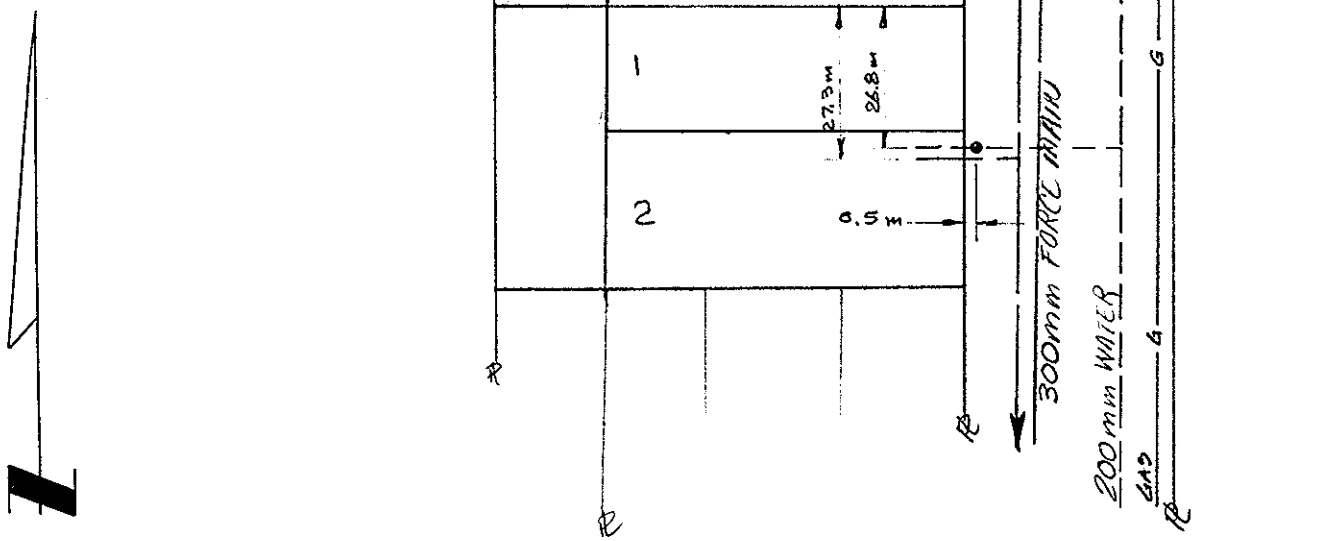
SITE PLAN N.T.S.