City of Prince George
HISTORY SHEET

SHEET NUMBER 14 of 40 ROLL NUMBER 024-834-912

Legal: LOT 14 D.L. 1599 PLAN PGP45787

Address: 3588 CHARTWELL AVE.

Sanitary Connection:# SIZE: 100mmø MATERIAL: PVC INV. 741.21m CONNECTED

Water Connection:# FROM MAIN: ~~25~~ 20mmø COPPER METER

Storm Connection:# SIZE 100mmø MATERIAL PVC INV. 741.21m CONNECTED

Cash Receipt No's: WATER SANITARY STORM

CURB FROM PROPERTY LINE 5.0m PAVEMENT WIDTH 10.0m

B.C. HYDRO 75mm DB2 U/G CONNECTION ✓

B.C. TELEPHONE 50mm DB2 U/G CONNECTION ✓

B.C. GAS 42 PROP/P.E.

Information Sheets: REF. DWGS. L&M ENGINEERING LTD. JOB. 1064-13-03 DWGS.(100-105)

Comments: (742.40) *PROPOSED FINAL LOT CORNER ELEVATION*
[741.90] EXISTING GUTTER ELEVATION

THE INFORMATION CONTAINED HEREIN IS FOR INTERNAL USE ONLY.
NOT TO BE RELIED UPON UNLESS CONFIRMED BY THE SITE INSPECTION AND/OR INVESTIGATION

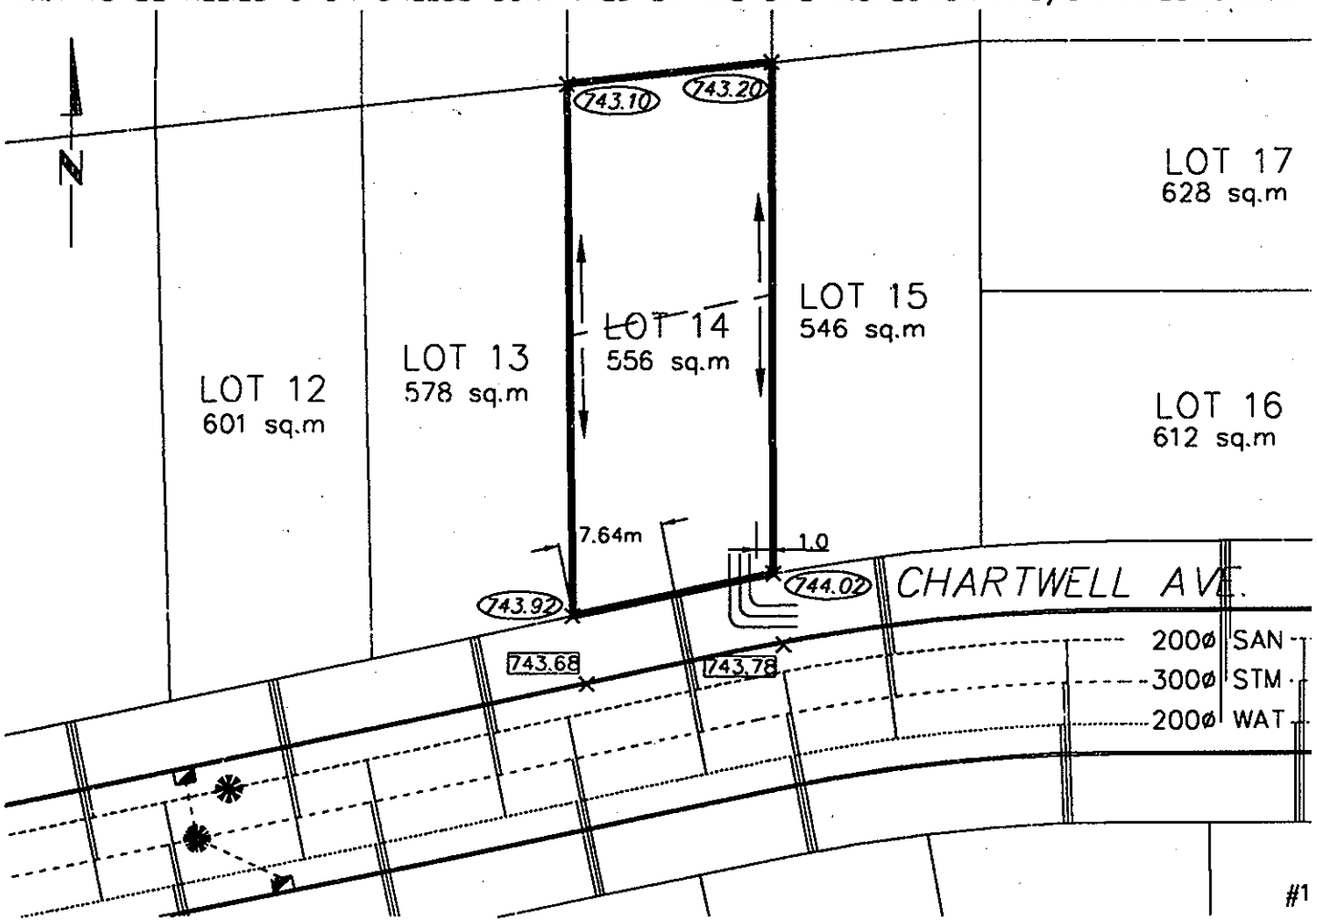

#1