# City of Prince George
## HISTORY SHEET

026136538

SHEET NUMBER 15 of 31 ROLL NUMBER

Legal: LOT 15 D.L. 754 PLAN BCP14774

Address: 7830 ST. MARY PL.

Sanitary Connection:# SIZE: 100mm# MATERIAL: WHT PVC SDR 28 INV. 653.44 CONNECTED

Water Connection:# FROM MAIN: 19mm# COPPER METER

Storm Connection:# SIZE 100mm# MATERIAL GRN PVC SDR 35 INV. 653.44 CONNECTED

Cash Receipt No's: WATER SANITARY STORM

CURB FROM PROPERTY LINE 5m PAVEMENT WIDTH 10m

B.C. HYDRO GREY 75mm DB2 U/G CONNECTION ✓

B.C. TELEPHONE ORANGE 50mm PVC DB2 U/G CONNECTION ✓

B.C. GAS YELLOW 15mm# P.E. SHAW CABLE ORANGE 25mm PVC

Information Sheets: REF. DWGS. L&M ENGINEERING LTD. JOB. 1106-04-03 DWGS.(201-204,401-403)

Comments: SEE LOT FILL CERTIFICATE PREPARED BY L&M ENGINEERING LTD.
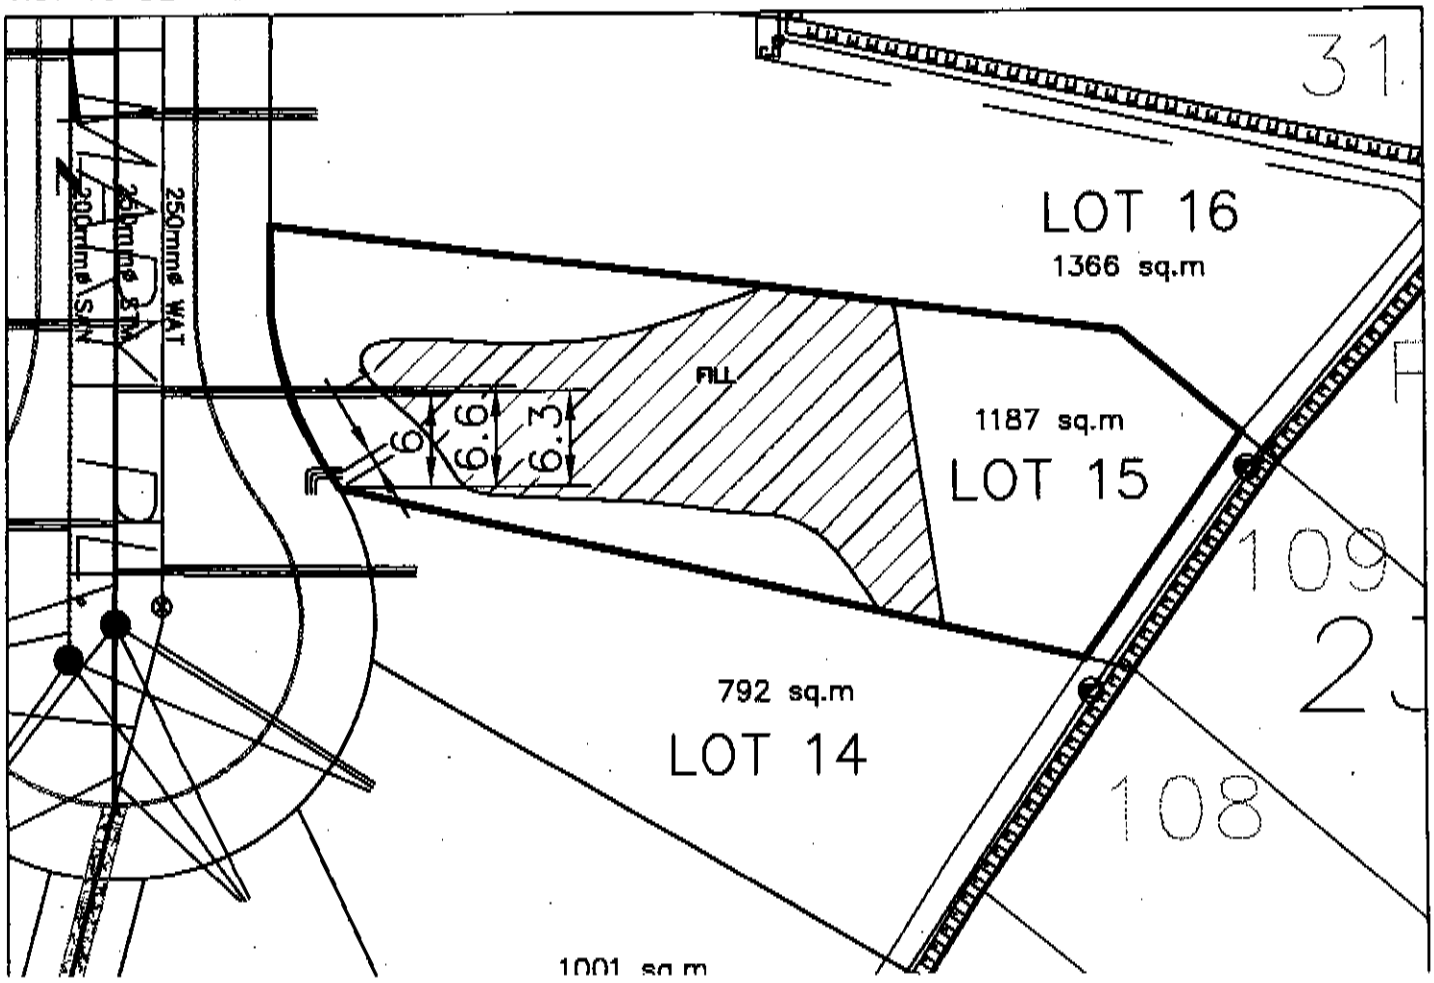
THE INFORMATION CONTAINED HEREIN IS FOR INTERNAL USE ONLY.
NOT TO BE RELIED UPON UNLESS CONFIRMED BY THE SITE INSPECTION AND/OR INVESTIGATION