City of Prince George
HISTORY SHEET

PID: 026534924

Legal: LOT 18 D.L. 4048 PLAN BCP 21607

Address: 6196 NARINDER PLACE / 6249 GURMIT ROAD

Sanitary Connection:# SIZE: 100mmø MATERIAL: PVC INV. 790.02m CONNECTED

Water Connection:# SIZE: 19mmø MATERIAL: COPPER INV. 790.10m METER

Storm Connection:# SIZE 100mmø MATERIAL PVC INV. 790.05m CONNECTED

Cash Receipt No's: WATER SANITARY STORM

CURB FROM PROPERTY LINE 5.0m PAVEMENT WIDTH 10.0m

B.C. HYDRO 75mm DB2 U/G CONNECTION ✓

B.C. TELEPHONE 50mm DB2 U/G CONNECTION ✓

B.C. GAS 42 PROP/P.E.

Information Sheets: REF. DWGS. L&M ENGINEERING LTD. JOB. 1256-01-02 DWGS. (001-406)

Comments: CS CURB STOP; CO CLEAN OUT; WDS WATER SERVICE, STORM SERVICE, SANITARY SERVICE; SS SHALLOW SERVICES (HYDRO, TELECOMMUNICATIONS, CABLE)
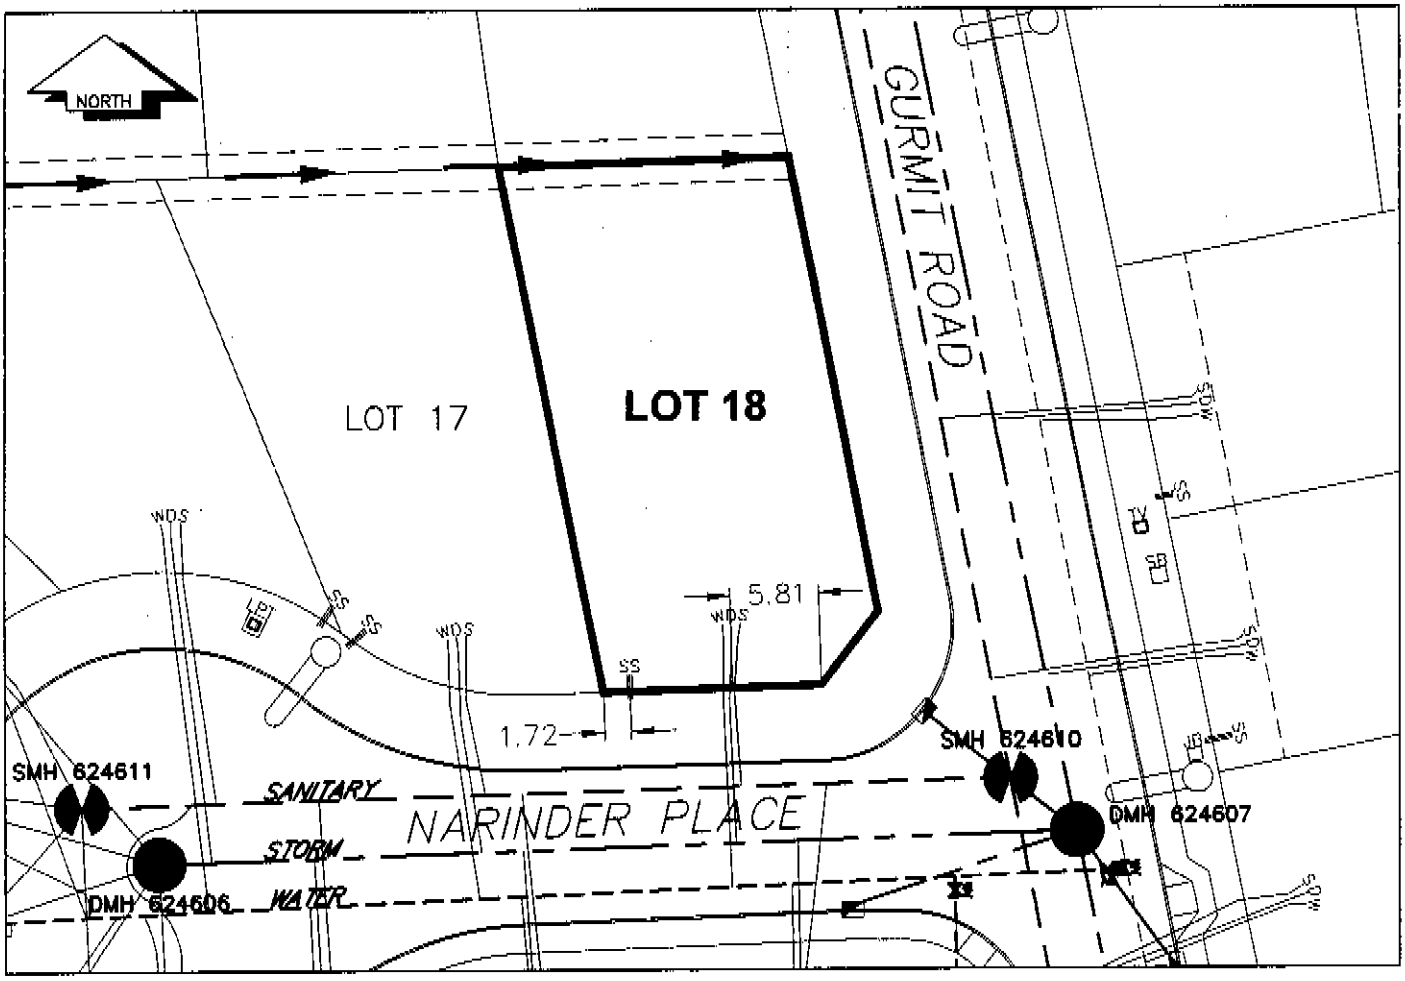
THE INFORMATION CONTAINED HEREIN IS FOR INTERNAL USE ONLY.
NOT TO BE RELIED UPON UNLESS CONFIRMED BY THE SITE INSPECTION AND/OR INVESTIGATION