City of Prince George
HISTORY SHEET

PID: 026762111

Legal: LOT 41 D.L. 2013 PLAN BCP24365

Address: 7605 Loedel Cr. SCALE: 1:500

Sanitary Connection:# SIZE: 100mmØ MATERIAL: PVC INV. 611.69 CONNECTED

Storm Connection:# N/A

Water Connection:# SIZE: 19mmØ MATERIAL: COPPER INV. 611.66 METER

Cash Receipt No's: WATER SANITARY STORM

CURB FROM PROPERTY LINE 5.0m PAVEMENT WIDTH 10.0m

B.C. HYDRO 75mm DB2 U/G CONNECTION ✓

TELUS 50mm DB2 U/G CONNECTION ✓

TERASEN 42 PROP/P.E.

Information Sheets: REF. DWGS. L&M ENGINEERING LTD. JOB. 1252-01-03 DWGS. (001-406)

Comments: CS CURB STOP; CO CLEAN OUT; SDW WATER SERVICE, STORM SERVICE, SANITARY SERVICE; TCH HYDRO SERVICE, CABLE SERVICE, TELECOMMUNICATIONS; STORM MAIN, SANITARY MAIN, WATER MAIN; GAS GAS MAIN; E ELECTRICAL MAIN
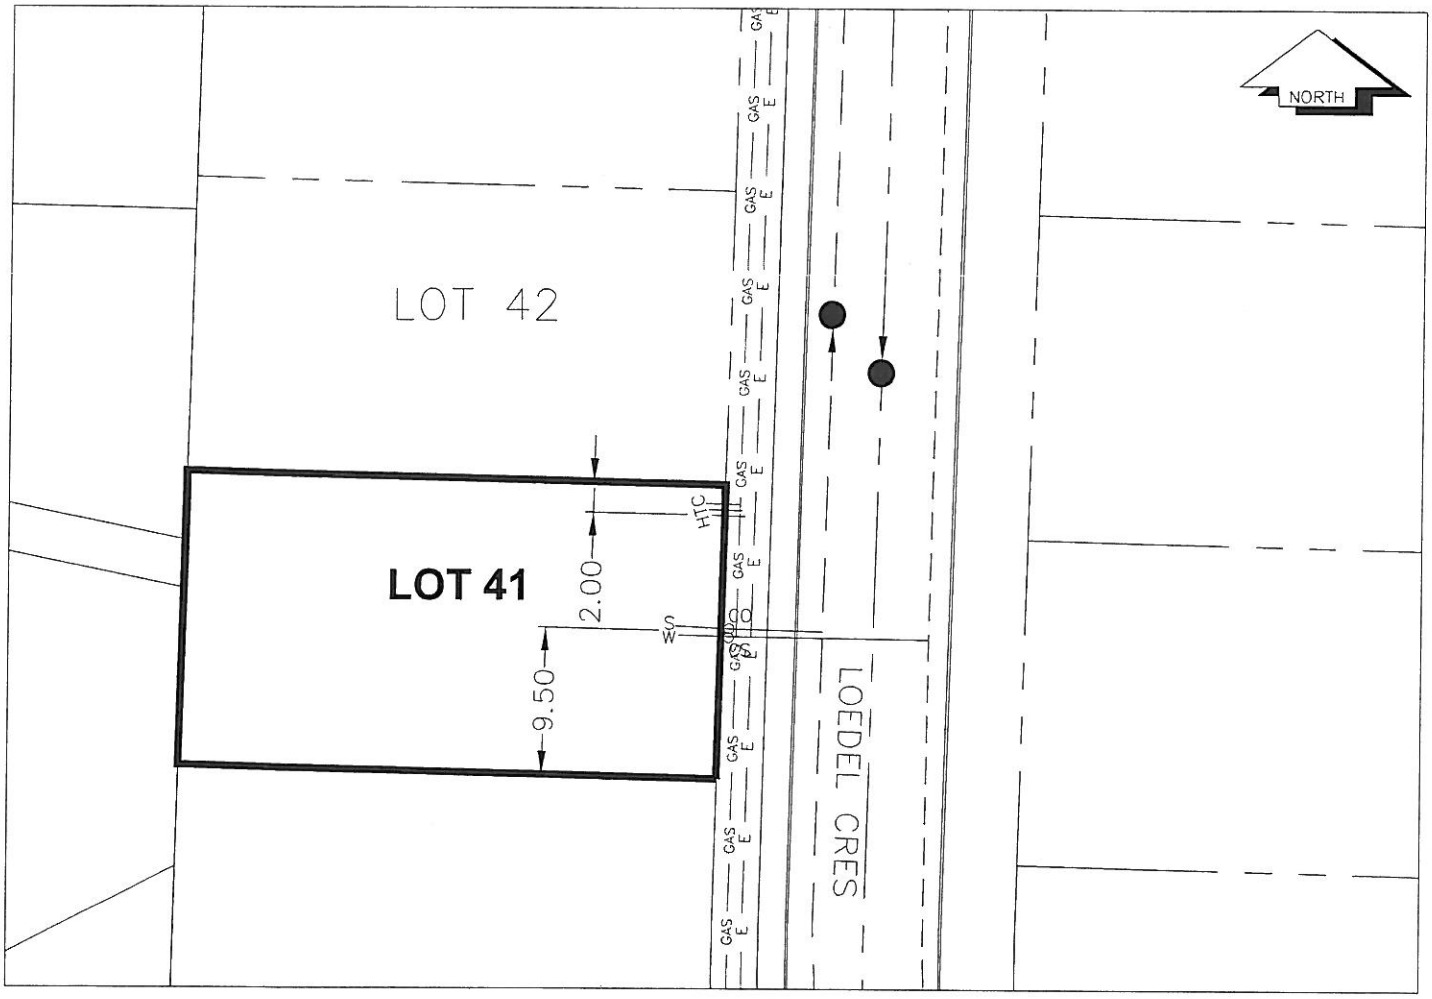
THE INFORMATION CONTAINED HEREIN IS FOR INTERNAL USE ONLY.
NOT TO BE RELIED UPON UNLESS CONFIRMED BY THE SITE INSPECTION AND/OR INVESTIGATION