City of Prince George
HISTORY SHEET

P.I.D. ~~000 000 000~~ 026776022

Legal: LOT 1 D.L. 4377 PLAN ~~BCP20570~~ BCP25435

Address: 2464 McTAVISH ROAD

Sanitary Connection:	SIZE:	100mmø	MATERIAL:	PVC	INV.	655.05m	CONNECTED
Water Connection:	SIZE:	19mmø	MATERIAL:	COPPER	INV.	655.74m	METER
Storm Connection:	SIZE	100mmø	MATERIAL	PVC	INV.	655.79m	CONNECTED

Cash Receipt No's: WATER SANITARY STORM

CURB FROM PROPERTY LINE 5.0m PAVEMENT WIDTH 10.0m

B.C. HYDRO 75mm DB2 U/G CONNECTION ✓

B.C. TELEPHONE 50mm DB2 U/G CONNECTION ✓

B.C. GAS 42 PROP/P.E.

Information Sheets: REF. DWGS. L&M ENGINEERING LTD. JOB. 1253-01-03 DWGS.(001-305)

Comments: CS CURB STOP; CO CLEAN OUT; WS WATER SERVICE; SD STORM SERVICE; SS SANITARY SERVICE; H HYDRO SERVICE; C CABLE SERVICE; T TELECOMMUNICATIONS

THE INFORMATION CONTAINED HEREIN IS FOR INTERNAL USE ONLY.
NOT TO BE RELIED UPON UNLESS CONFIRMED BY THE SITE INSPECTION AND/OR INVESTIGATION

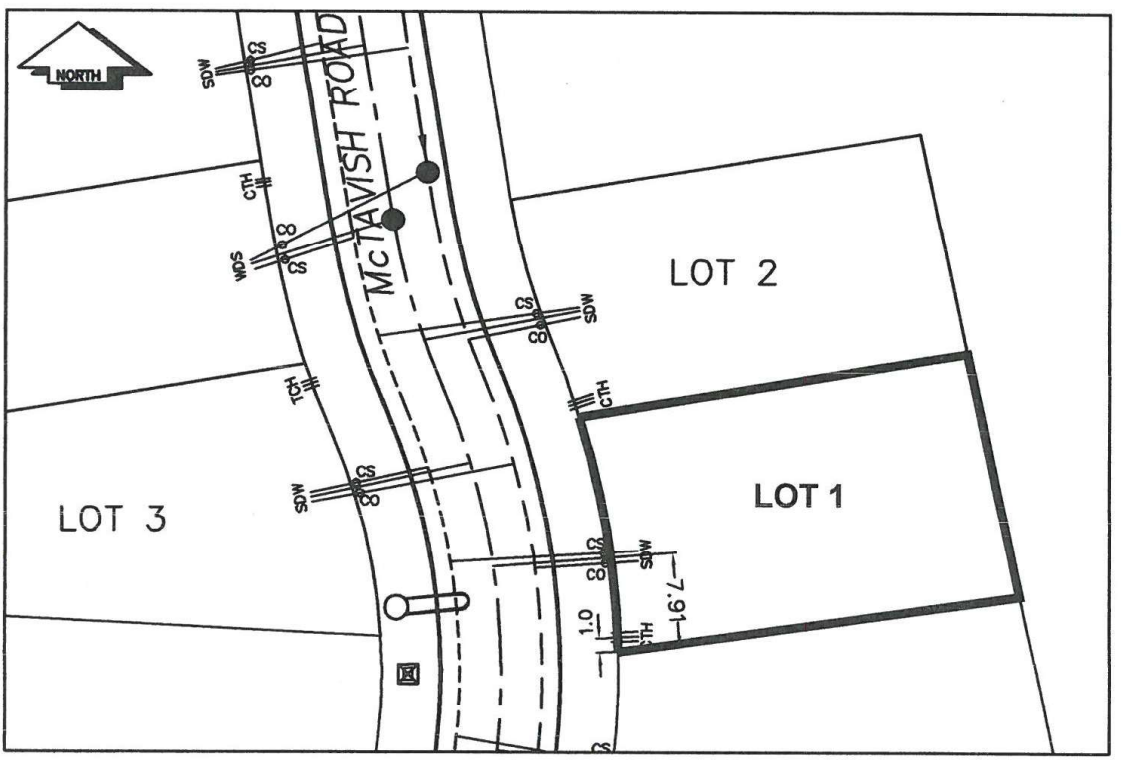

LOT 1

SANITARY, STORM & WATER SERVICE INVERTS	SANITARY	STORM	WATER
1. Distance from San. M.H. S-7 to connection point is 78.62 toward San. MH 514602		N/A	N/A
1a. Distance from Stm. M.H. D-8 to connection point is 85.39 toward Stm. MH 513603	N/A		N/A
2. Main Size at connection point is	200mmø	300mmø	250mmø
3. Invert of main at conn. stub pt is	654.72	655.46	655.43
4. Invert at service end is	655.05	655.79	655.76
5. Cut at P/I in meters	3.3m	2.5m	3.0m
6. Survey Date AUGUST 20 05 Book Ref. 1253-01-03 by KILBRIDE			

SANITARY HISTORY:

WATER HISTORY:

STORM HISTORY: