City of Prince George
HISTORY SHEET

PID: 027-140-091

Legal: LOT 10 D.L. 2003 PLAN BCP 31246

Address: 1413 Omineca Pl./4700 Gannett Rd. SCALE: 1:500

Sanitary Connection:# SIZE: 100mmØ MATERIAL: PVC INV. 670.48

Water Connection:# SIZE: 19mmØ MATERIAL: COPPER INV. 670.33

Storm Connection:# SIZE: 100mmØ MATERIAL: PVC INV. 670.49

Cash Receipt No's: WATER SANITARY STORM

CURB FROM PROPERTY LINE 5.0m PAVEMENT WIDTH 10.0m

B.C. HYDRO 75mm DB2 U/G CONNECTION ✓

TELUS 50mm DB2 U/G CONNECTION ✓

TERASEN 42 PROP/P.E.

Information Sheets: REF. DWGS. L&M ENGINEERING LTD. JOB. 1265-01-03 DWGS. (001-406)

Comments: CS CURB STOP; CO CLEAN OUT; SDW WATER SERVICE, STORM SERVICE, SANITARY SERVICE; TCH HYDRO SERVICE, CABLE SERVICE, TELECOMMUNICATIONS; STORM MAIN; SANITARY MAIN; WATER MAIN; GAS GAS MAIN; E ELECTRICAL MAIN
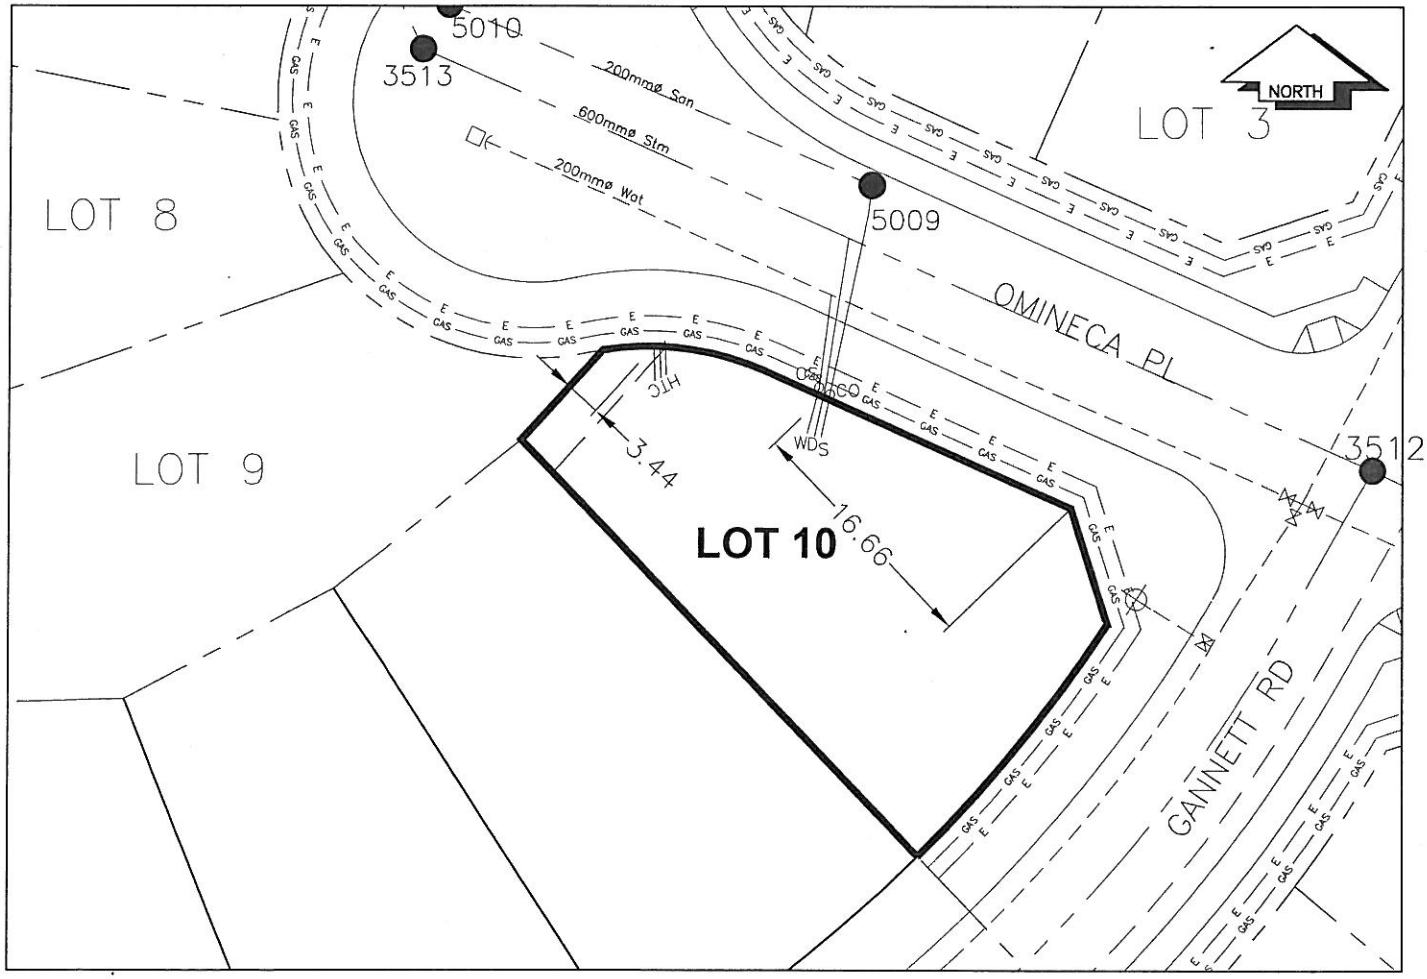
THE INFORMATION CONTAINED HEREIN IS FOR INTERNAL USE ONLY.
NOT TO BE RELIED UPON UNLESS CONFIRMED BY THE SITE INSPECTION AND/OR INVESTIGATION