City of Prince George
HISTORY SHEET

PID: 027614841 Scale: 1:500

Legal: LOT 1 D.L.: 4377 PLAN: BCP37759

Address: 2601 LINKS DRIVE

Sanitary Connection:#	SIZE:	100mmØ	MATERIAL:	PVC	INV.	653.00m	CONNECTED
Water Connection:#	SIZE:	19mmØ	MATERIAL:	COPPER	INV.	653.10m	
Storm Connection:#	SIZE	100mmØ	MATERIAL	PVC	INV.	653.00m	CONNECTED

Cash Receipt No's: WATER SANITARY STORM

CURB FROM PROPERTY LINE 5.0 m PAVEMENT WIDTH 10.0 m

HYDRO 75mm DB2 U/G CONNECTION ✓

TELEPHONE 50mm DB2 U/G CONNECTION ✓

GAS 42 PROP/P.E

Information Sheets: REF. DWGS. L&M ENGINEERING LTD. JOB. 1253-02-04 DWGS

Comments:

CS CURB STOP
CO CLEAN OUT
SDW WATER SERVICE
STORM SERVICE
SANITARY SERVICE
HYDRO SERVICE
CABLE SERVICE
TELECOMMUNICATIONS
GAS
ELECTRICAL
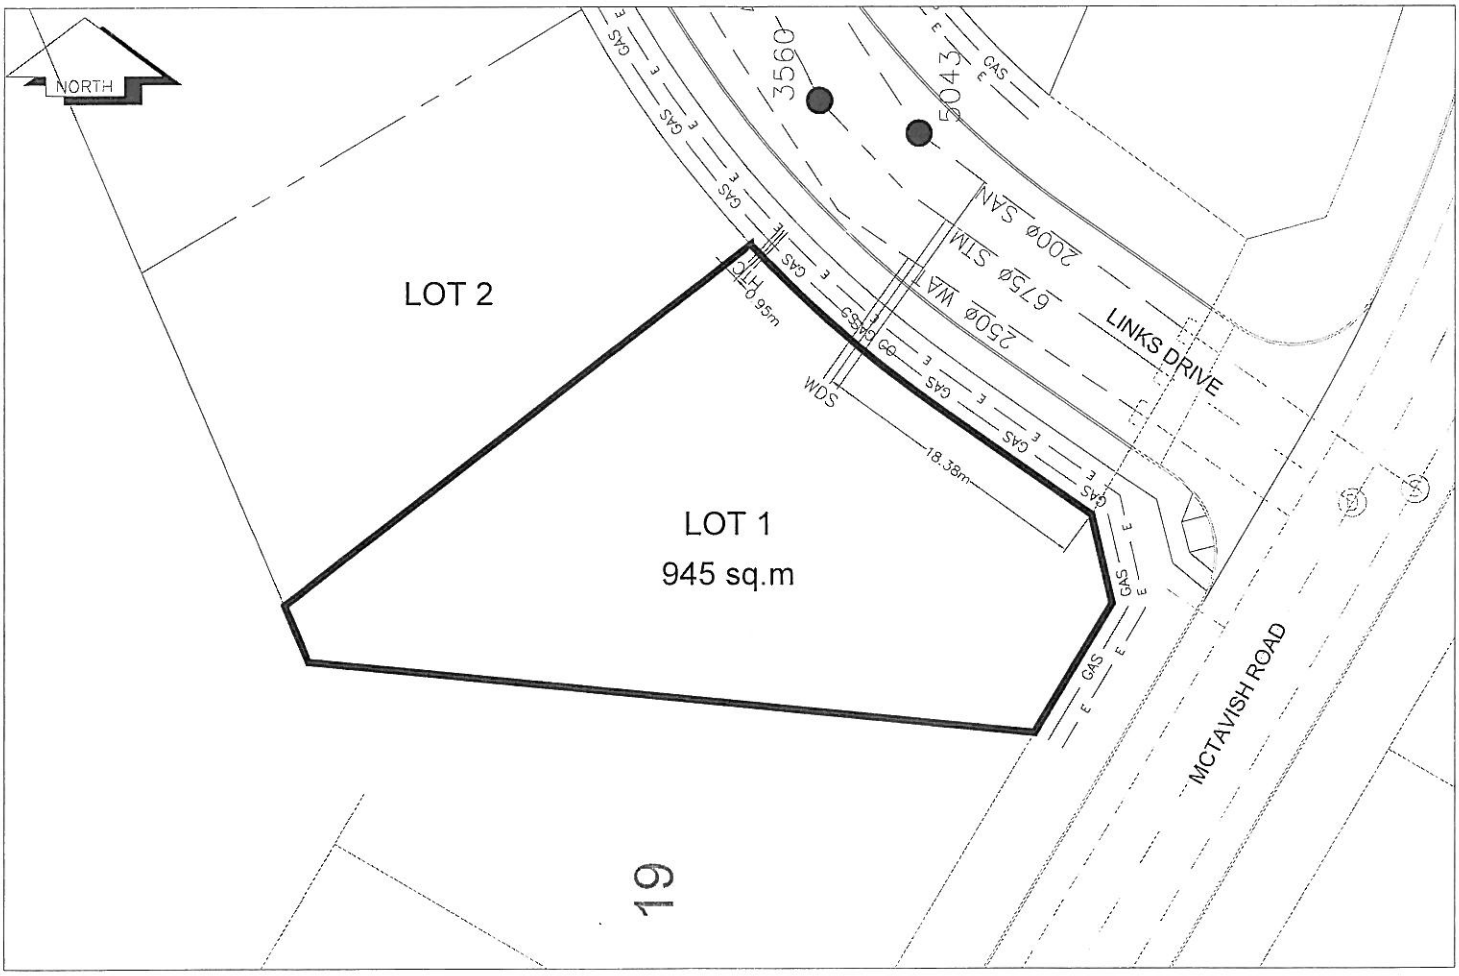
THE INFORMATION CONTAINED HEREIN IS FOR INTERNAL USE ONLY.
NOT TO BE RELIED UPON UNLESS CONFIRMED BY THE SITE INSPECTION AND/OR INVESTIGATION