2012-05-28

City of Prince George
HISTORY SHEET

PID: 028847881 Scale: 1:500

Legal: LOT 13 D.L.: 2014 PLAN: EPP16518

Address: 8017 Stillwater Cres

Sanitary Connection:#	SIZE:	100mmØ	MATERIAL:	PVC	INV.	584.63	CONNECTED
Water Connection:#	SIZE:	19mmØ	MATERIAL:	copper	INV.	583.86	METER
Storm Connection:#	SIZE	100mmØ	MATERIAL	PVC	INV.	584.63	CONNECTED

Cash Receipt No's: WATER SANITARY STORM

CURB FROM PROPERTY LINE 5m PAVEMENT WIDTH 8.5m

B.C. HYDRO 75mm DB2 U/G CONNECTION ✓

B.C. TELEPHONE 50mm DB2 U/G CONNECTION ✓

TERASEN 42 PROP/P.E.

Information Sheets: REFERENCE DRAWINGS L&M ENGINEERING LIMITED JOB NO. 1140-07-04

Comments:

CS CURB STOP
CO CLEAN OUT
SDW WATER SERVICE / STORM SERVICE / SANITARY SERVICE
CH HYDRO SERVICE / CABLE SERVICE / TELECOMMUNICASTIONS
GAS GAS
E ELECTRICAL

THE INFORMATION CONTAINED HEREIN IS FOR INTERNAL USE ONLY.
NOT TO BE RELIED UPON UNLESS CONFIRMED BY THE SITE INSPECTION AND/OR INVESTIGATION

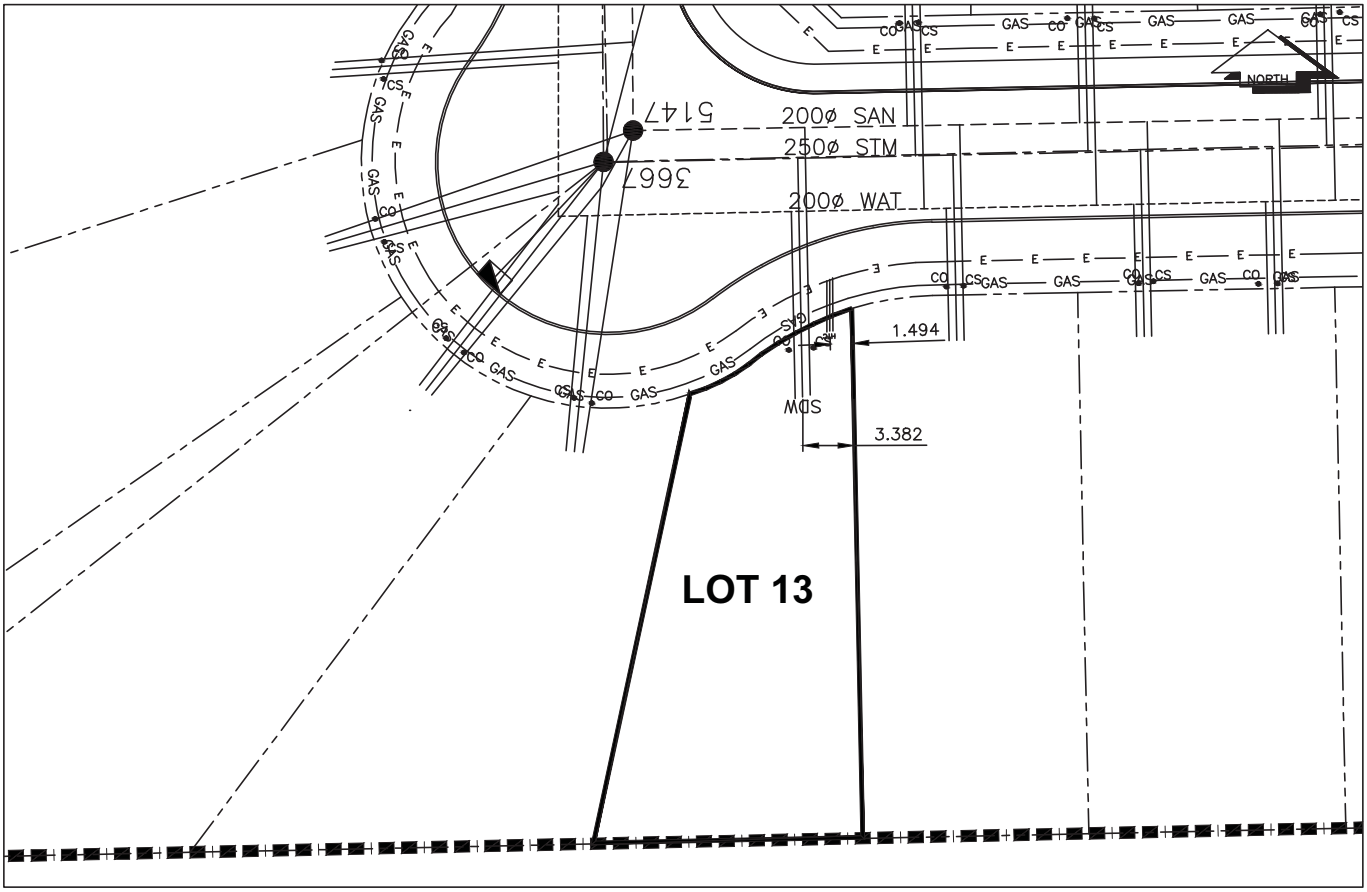

Lot 13

SANITARY, STORM & WATER SERVICE INVERTS	SANITARY	WATER	STORM
1. Distance from San. M.H. 5147 toward San. M.H. 5146 to lot service connection point is:	22m	N/A	N/A
1a.Distance from Stm. M.H. 3667 toward Stm. M.H. 3666 to lot service connection point is:	N/A	N/A	24m
2. Main Size at connection point is	200mm	200mm	250mm
3. Invert of main at conn. stub point is	582.34	583.58	582.41
4. Invert at service end is	584.63	583.86	584.63
5. Cut at property line in meters	2.25m	3.02m	2.25m
6. Survey Date: OCT 2009 Book Ref.: 1140-07-04 By: FORESIGHT SURVEY & DESIGN			

SANITARY HISTORY:

Installed By: Fortwood Homes Ltd.

WATER HISTORY:

Installed By: Fortwood Homes Ltd.

STORM HISTORY:

Installed By: Fortwood Homes Ltd.