2012-05-28

City of Prince George
HISTORY SHEET

PID:	028848128				Scale:	1:500	
Legal:	LOT 34				D.L.:	2014	PLAN: EPP16518
Address:	7664 Stillwater Cres						
Sanitary Connection:#		SIZE:	100mmØ	MATERIAL:	PVC	INV. 583.97	CONNECTED
Water Connection:#		SIZE:	19mmØ	MATERIAL:	copper	INV. 583.50	METER
Storm Connection:#		SIZE	100mmØ	MATERIAL	PVC	INV. 584.00	CONNECTED
Cash Receipt No's:		WATER		SANITARY		STORM	
CURB FROM PROPERTY LINE	5m					PAVEMENT WIDTH	8.5m
B.C. HYDRO	75mm DB2			U/G CONNECTION		✓	
B.C. TELEPHONE	50mm DB2			U/G CONNECTION		✓	
TERASEN	42 PROP/P.E.						
Information Sheets:	REFERENCE DRAWINGS L&M ENGINEERING LIMITED JOB NO. 1140-07-04						

Comments:
CS CURB STOP
CO CLEAN OUT
WATER SERVICE
STORM SERVICE
SANITARY SERVICE
HYDRO SERVICE
CABLE SERVICE
TELECOMMUNICASTIONS
GAS GAS
E ELECTRICAL

THE INFORMATION CONTAINED HEREIN IS FOR INTERNAL USE ONLY.
NOT TO BE RELIED UPON UNLESS CONFIRMED BY THE SITE INSPECTION AND/OR INVESTIGATION

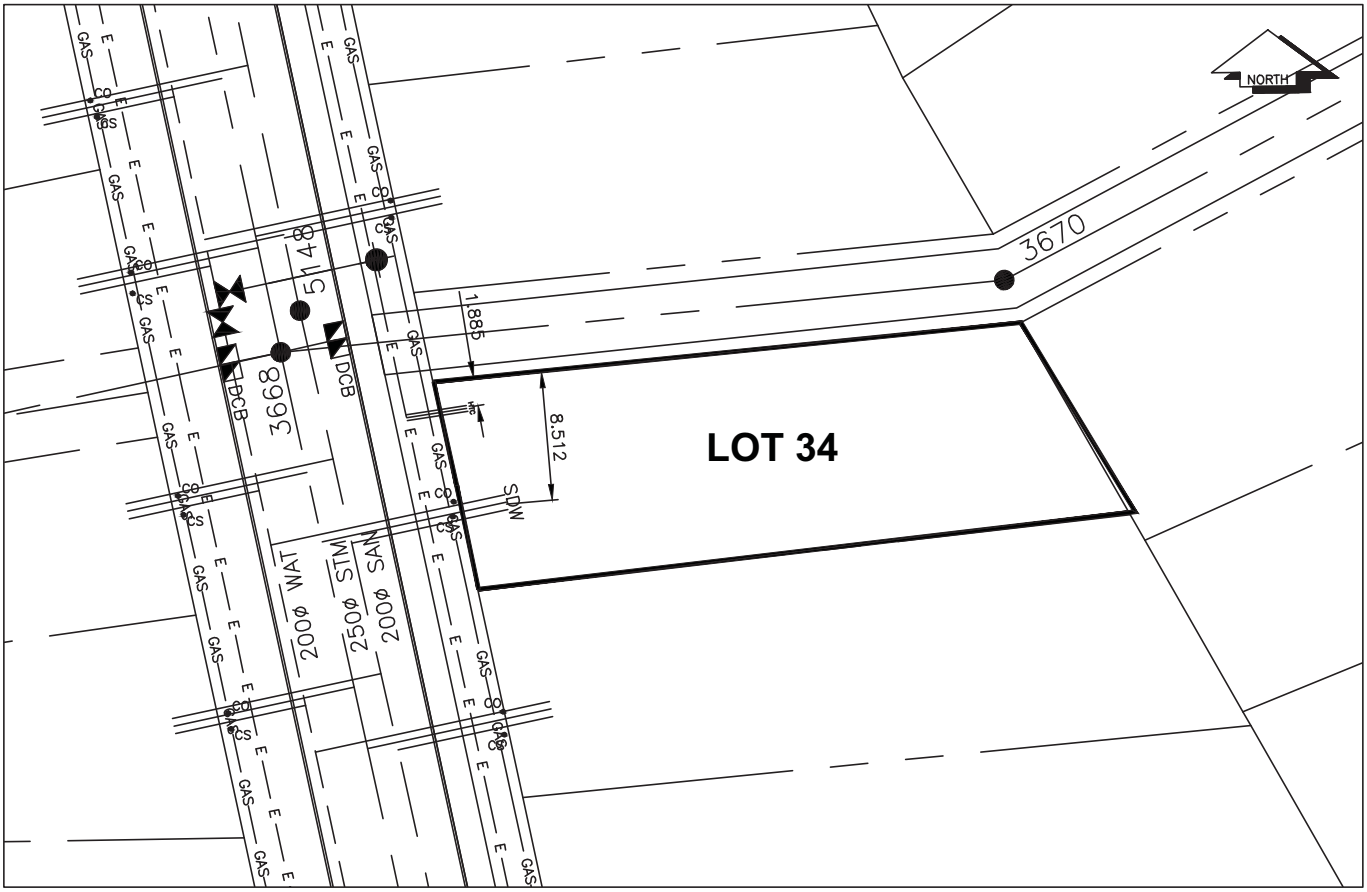

Lot 34

SANITARY, STORM & WATER SERVICE INVERTS	SANITARY	WATER	STORM
1. Distance from San. M.H. 5147 toward San. M.H. 5148 to lot service connection point is:	75m	N/A	N/A
1a.Distance from Stm. M.H. 3667 toward Stm. M.H. 3668 to lot service connection point is:	N/A	N/A	78m
2. Main Size at connection point is	200mm	200mm	250mm
3. Invert of main at conn. stub point is	582.34	583.58	582.41
4. Invert at service end is	583.97	583.50	584.00
5. Cut at property line in meters	2.27m	2.74m	2.24m
6. Survey Date: OCT 2009 Book Ref.: 1140-07-04 By: FORESIGHT SURVEY & DESIGN			

SANITARY HISTORY:

Installed By: Fortwood Homes Ltd.

WATER HISTORY:

Installed By: Fortwood Homes Ltd.

STORM HISTORY:

Installed By: Fortwood Homes Ltd.