2012-05-28

# City of Prince George

## HISTORY SHEET

| | | | | | | | |
|---|---|---|---|---|---|---|---|
| PID: | 028848179 | | | | Scale: | 1:500 | |
| Legal: | LOT 39 | | | | D.L.: | 2014 | PLAN: EPP16518 |
| Address: | 7615 Creekside Way | | | | | | |
| Sanitary Connection:# | | SIZE: | 100mmØ | MATERIAL: | PVC | INV. 583.38 | CONNECTED |
| Water Connection:# | | SIZE: | 19mmØ | MATERIAL: | copper | INV. 583.41 | METER |
| Storm Connection:# | | SIZE | 100mmØ | MATERIAL | PVC | INV. 583.40 | CONNECTED |
| Cash Receipt No's: | | WATER | | SANITARY | | STORM | |
| CURB FROM PROPERTY LINE | 5m | | | | | PAVEMENT WIDTH | 10m |
| B.C. HYDRO | 75mm DB2 | | | U/G CONNECTION | | ✓ | |
| B.C. TELEPHONE | 50mm DB2 | | | U/G CONNECTION | | ✓ | |
| TERASEN | 42 PROP/P.E. | | | | | | |
| Information Sheets: | REFERENCE DRAWINGS L&M ENGINEERING LIMITED JOB NO. 1140-07-04 | | | | | | |

Comments:

CS CURB STOP
CO CLEAN OUT
SDW WATER SERVICE
STORM SERVICE
SANITARY SERVICE
CH HYDRO SERVICE
CABLE SERVICE
TELECOMMUNICASTIONS
GAS GAS
E ELECTRICAL

THE INFORMATION CONTAINED HEREIN IS FOR INTERNAL USE ONLY.
NOT TO BE RELIED UPON UNLESS CONFIRMED BY THE SITE INSPECTION AND/OR INVESTIGATION

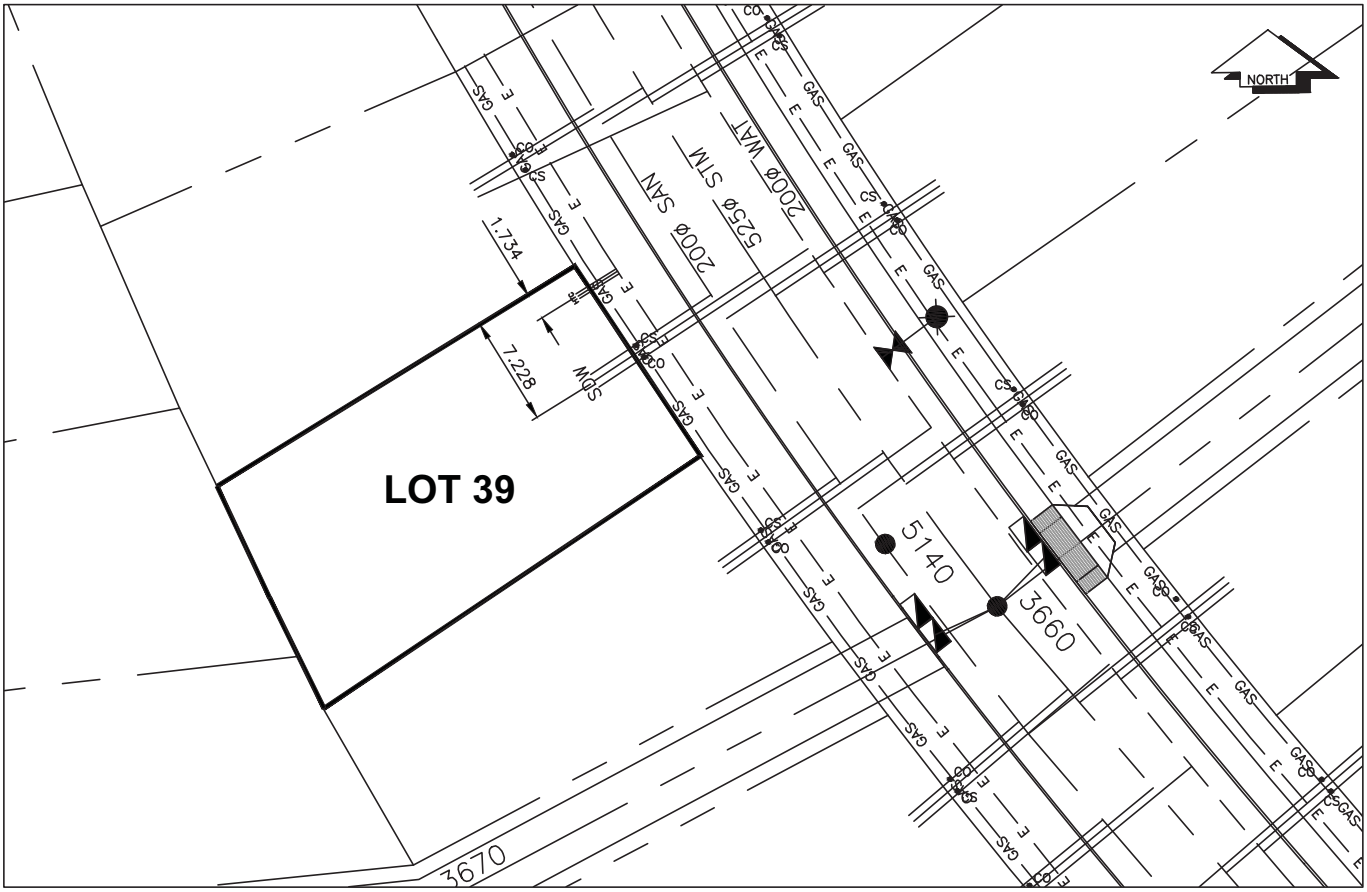

Lot 39

| SANITARY, STORM & WATER SERVICE INVERTS | SANITARY | WATER | STORM |
|---|---|---|---|
| 1. Distance from San. M.H. 5140 toward San. M.H. 5139 to lot service connection point is: | 99m | N/A | N/A |
| 1a.Distance from Stm. M.H. 3659 toward Stm. M.H. 3660 to lot service connection point is: | N/A | N/A | 57m |
| 2. Main Size at connection point is | 200mm | 200mm | 525mm |
| 3. Invert of main at conn. stub point is | 582.34 | 583.58 | 582.41 |
| 4. Invert at service end is | 583.38 | 583.41 | 583.40 |
| 5. Cut at property line in meters | 2.58m | 2.55m | 2.56m |
| 6. Survey Date: OCT 2009 Book Ref.: 1140-07-04 By: FORESIGHT SURVEY & DESIGN | | | |
| | | | |
| | | | |
| | | | |
| | | | |
| | | | |
| | | | |
| | | | |

## SANITARY HISTORY:

Installed By: Fortwood Homes Ltd.

## WATER HISTORY:

Installed By: Fortwood Homes Ltd.

## STORM HISTORY:

Installed By: Fortwood Homes Ltd.