2012-05-28

# City of Prince George
## HISTORY SHEET

PID: 028848187 Scale: 1:500

Legal: LOT 40 D.L.: 2014 PLAN: EPP16518

Address: 7627 Creekside Way

| | | | | | | | |
|---|---|---|---|---|---|---|---|
| Sanitary Connection:# | SIZE: | 100mmØ | MATERIAL: | PVC | INV. | 583.43 | CONNECTED |
| Water Connection:# | SIZE: | 19mmØ | MATERIAL: | copper | INV. | 582.68 | METER |
| Storm Connection:# | SIZE | 100mmØ | MATERIAL | PVC | INV. | 583.53 | CONNECTED |

Cash Receipt No's: WATER SANITARY STORM

CURB FROM PROPERTY LINE 5m PAVEMENT WIDTH 10m

B.C. HYDRO 75mm DB2 U/G CONNECTION ✓

B.C. TELEPHONE 50mm DB2 U/G CONNECTION ✓

TERASEN 42 PROP/P.E.

Information Sheets: REFERENCE DRAWINGS L&M ENGINEERING LIMITED JOB NO. 1140-07-04

Comments:

CS CURB STOP
CO CLEAN OUT
SDW WATER SERVICE / STORM SERVICE / SANITARY SERVICE
CH HYDRO SERVICE / CABLE SERVICE / TELECOMMUNICASTIONS
GAS GAS
E ELECTRICAL

THE INFORMATION CONTAINED HEREIN IS FOR INTERNAL USE ONLY.
NOT TO BE RELIED UPON UNLESS CONFIRMED BY THE SITE INSPECTION AND/OR INVESTIGATION

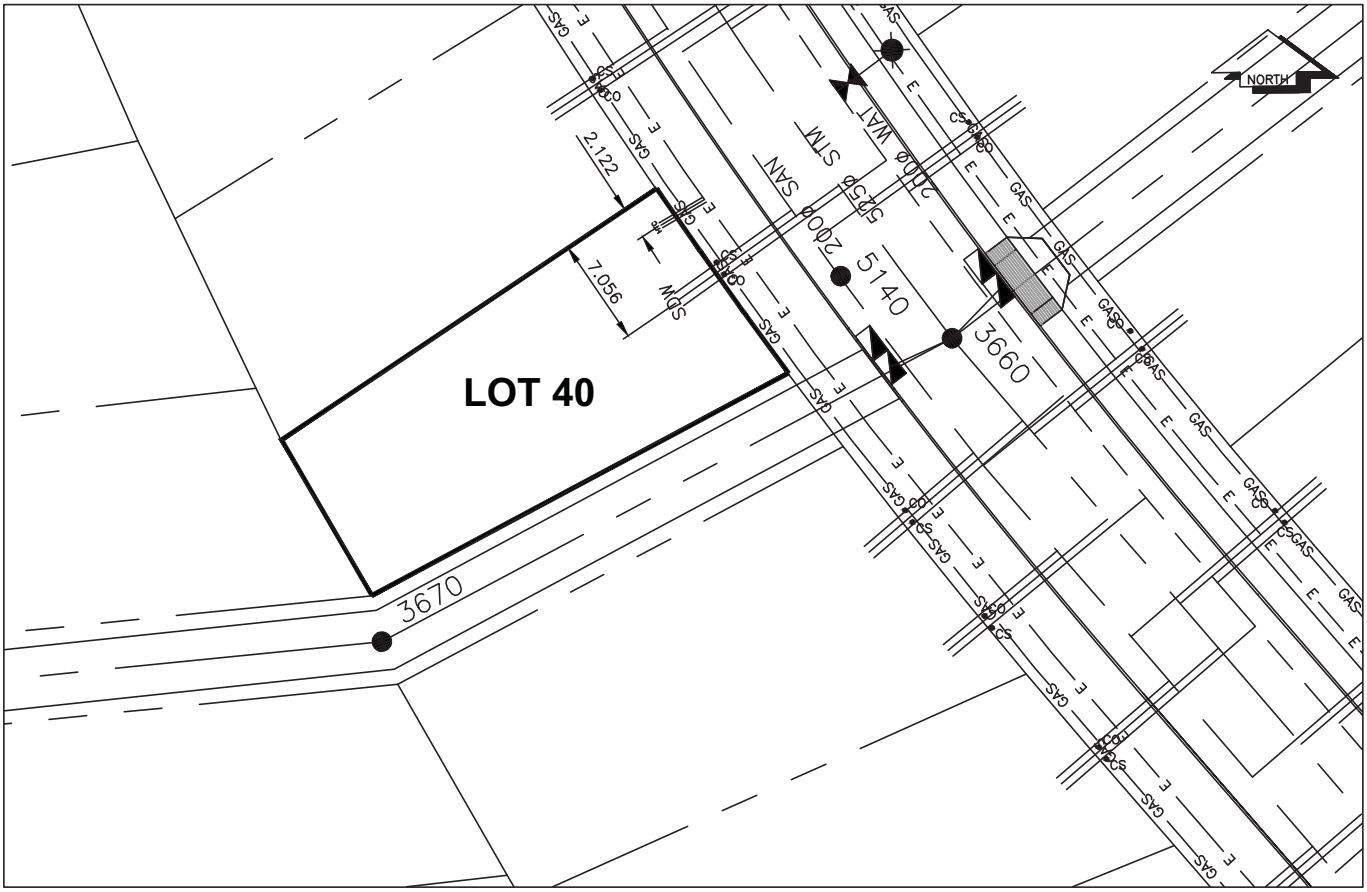

Lot 40

| SANITARY, STORM & WATER SERVICE INVERTS | SANITARY | WATER | STORM |
|---|---|---|---|
| 1. Distance from San. M.H. 5139 toward San. M.H. 5140 to lot service connection point is: | 114m | N/A | N/A |
| 1a.Distance from Stm. M.H. 3659 toward Stm. M.H. 3660 to lot service connection point is: | N/A | N/A | 70m |
| 2. Main Size at connection point is | 200mm | 200mm | 525mm |
| 3. Invert of main at conn. stub point is | 582.34 | 583.58 | 582.41 |
| 4. Invert at service end is | 583.43 | 582.68 | 583.43 |
| 5. Cut at property line in meters | 2.44m | 3.19m | 2.44m |
| 6. Survey Date: OCT 2009 Book Ref.: 1140-07-04 By: FORESIGHT SURVEY & DESIGN | | | |
| | | | |
| | | | |
| | | | |
| | | | |
| | | | |
| | | | |
| | | | |

## SANITARY HISTORY:

Installed By: Fortwood Homes Ltd.

## WATER HISTORY:

Installed By: Fortwood Homes Ltd.

## STORM HISTORY:

Installed By: Fortwood Homes Ltd.