2012-05-28

City of Prince George

HISTORY SHEET

PID:	028848250				Scale:	1:500	
Legal:	LOT 47				D.L.:	2014	PLAN: EPP16518
Address:	7630 Creekside Way						
Sanitary Connection:#		SIZE:	100mmØ	MATERIAL:	PVC	INV. 583.32	CONNECTED
Water Connection:#		SIZE:	19mmØ	MATERIAL:	copper	INV. 583.02	METER
Storm Connection:#		SIZE	100mmØ	MATERIAL	PVC	INV. 583.35	CONNECTED
Cash Receipt No's:		WATER		SANITARY		STORM	
CURB FROM PROPERTY LINE	5m					PAVEMENT WIDTH	10m
B.C. HYDRO	75mm DB2			U/G CONNECTION		✓	
B.C. TELEPHONE	50mm DB2			U/G CONNECTION		✓	
TERASEN	42 PROP/P.E.						
Information Sheets:	REFERENCE DRAWINGS L&M ENGINEERING LIMITED JOB NO. 1140-07-04						

Comments:

CS CURB STOP
CO CLEAN OUT
SDW WATER SERVICE / STORM SERVICE / SANITARY SERVICE
CH HYDRO SERVICE / CABLE SERVICE / TELECOMMUNICASTIONS
GAS GAS
E ELECTRICAL

THE INFORMATION CONTAINED HEREIN IS FOR INTERNAL USE ONLY.
NOT TO BE RELIED UPON UNLESS CONFIRMED BY THE SITE INSPECTION AND/OR INVESTIGATION

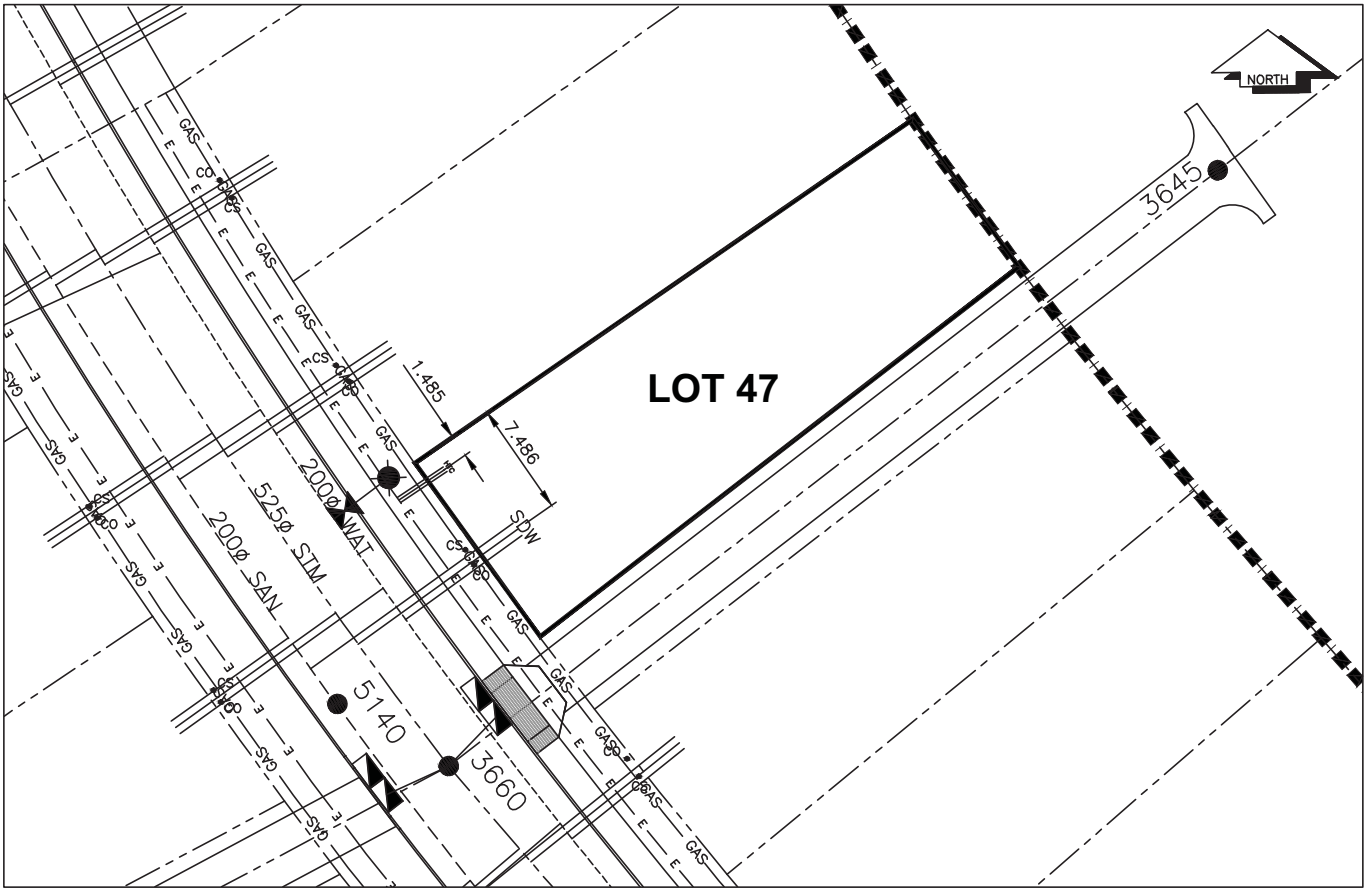

Lot 47

SANITARY, STORM & WATER SERVICE INVERTS	SANITARY	WATER	STORM
1. Distance from San. M.H. 5140 toward San. M.H. 5139 to lot service connection point is:	2.5m	N/A	N/A
1a.Distance from Stm. M.H. 3659 toward Stm. M.H. 3660 to lot service connection point is:	N/A	N/A	11m
2. Main Size at connection point is	200mm	200mm	525mm
3. Invert of main at conn. stub point is	582.34	583.58	582.41
4. Invert at service end is	583.32	583.02	583.35
5. Cut at property line in meters	2.48m	2.78m	2.45m
6. Survey Date: OCT 2009 Book Ref.: 1140-07-04 By: FORESIGHT SURVEY & DESIGN			

SANITARY HISTORY:

Installed By: Fortwood Homes Ltd.

WATER HISTORY:

Installed By: Fortwood Homes Ltd.

STORM HISTORY:

Installed By: Fortwood Homes Ltd.