City of Prince George

HISTORY SHEET

PID: 029-575-907 Scale: 1:500

Legal: LOT 43 D.L.: 1605 PLAN: EPP41947

Address: 2894 Vista Ridge Dr.

Sanitary Connection:#	SIZE:	100mmØ	MATERIAL:	PVC	INV. AT ℞	676.94m	CONNECTED
Water Connection:#	SIZE:	19mmØ	MATERIAL:	Copper	INV. AT ℞	677.01m	
Storm Connection:#	SIZE	100mmØ	MATERIAL	PVC	INV. AT ℞	676.92m	CONNECTED

Cash Receipt No's: WATER SANITARY STORM

CURB FROM PROPERTY LINE 5m PAVEMENT WIDTH 10m

HYDRO 75mm DB2 U/G CONNECTION ✓

TELEPHONE 100mm DB2 U/G CONNECTION ✓

GAS 42 PROP/P.E.

Information Sheets: REF. DWGS. L&M ENGINEERING LTD. JOB. 1106-11-04 DWGS.

Comments:

CS CURB STOP
CO CLEAN OUT
SDW WATER SERVICE
STORM SERVICE
SANITARY SERVICE
TCH HYDRO SERVICE
CABLE SERVICE
TELECOMMUNICASTIONS
GAS
E ELECTRICAL

THE INFORMATION CONTAINED HEREIN IS FOR INTERNAL USE ONLY.
NOT TO BE RELIED UPON UNLESS CONFIRMED BY THE SITE INSPECTION AND/OR INVESTIGATION

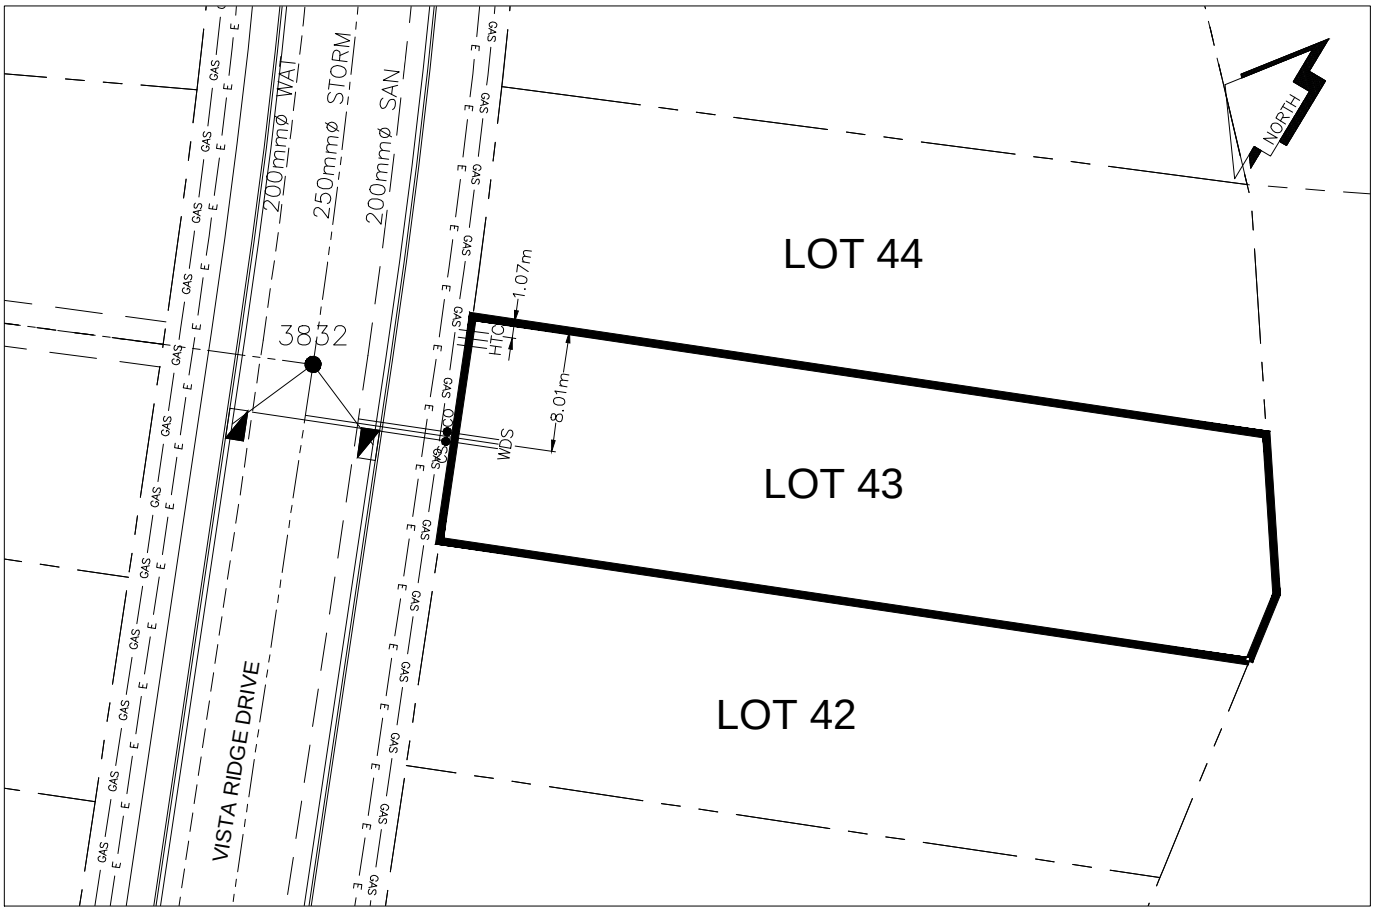

LOT 43

SANITARY, STORM & WATER SERVICE INVERTS	SANITARY	WATER	STORM
1. Distance from San. M.H. 5258 toward San. M.H. 5259 to lot service connection point is:	54.92m	N/A	N/A
1a.Distance from Stm. M.H. 3832 toward Stm. M.H. 3833 to lot service connection point is:	N/A	N/A	3.42m
2. Main Size at connection point is	200mmØ	200mmØ	250mmØ
3. Invert of service at main conn. stub point is	676.27m	676.69m	676.45m
4. Invert at service end is	677.02m	677.09m	677.00m
5. Cover at property line in meters	2.71m	2.72m	2.73m
6. Survey Date: JUNE 2013 Book Ref.:1106-11-04 By:L&M ENGINEERING LTD			

SANITARY HISTORY:

DATE INSTALLED: JUNE 2013

INSTALLED BY: SUNLAND UTILITIES LTD

WATER HISTORY:

DATE INSTALLED: JUNE 2013

INSTALLED BY: SUNLAND UTILITIES LTD.

STORM HISTORY:

DATE INSTALLED: JUNE 2013

INSTALLED BY: SUNLAND UTILITIES LTD.