Update requested 2018 (SD100505 / MU101838) - CFS Call 303839

CITY OF PRINCE GEORGE

# History Sheet

**(Internal Use Only)**

Revision Date:: 12/2/2013

| | | | | | | | |
|---|---|---|---|---|---|---|---|
| *Address:* | **5354 Shellburn Rd** | | *PID:* | **006257721** | | Installation Date: | **07/15/2013** |
| *Legal:* | A | *BLK:* | | *DL:* | 954 | *PL:* | 14964 EXCEPT PLAN 27408 |

| | | | | | | | | | |
|---|---|---|---|---|---|---|---|---|---|
| *Sanitary Connection #:* | | *Size:* | 100mm | *Material:* | PVC | *Depth:* | 2.150 | *Connected:* | No |
| *Water Connection #:* | | *Size:* | 20mm | *Material:* | CU | *Depth:* | 2.250 | *Connected:* | No |
| *Storm Connection #:* | N/A | *Size:* | | *Material:* | | *Depth:* | | *Connected:* | |
| *Fibreoptics:* | N/A | *Size:* | | *Material:* | | *Depth:* | | *Connected:* | |

*Additional Information:*

*Cash Receipts Nos:* *Water:* *Sanitary:* *Storm:*

*Curb from Property Line:* N/A *Pavement Width:* Gravel - 6.8m

*Shaw:* Overhead

*BC Hydro:* Overhead

*TELUS:* Overhead

*Terasen:* None

*Other:*

*Other:*

*Comments:* City Prospero File MU101341

*NOTE: **The information contained herein is for internal use only. Not to be relied upon unless confirmed by site inspection and/or investigation.*
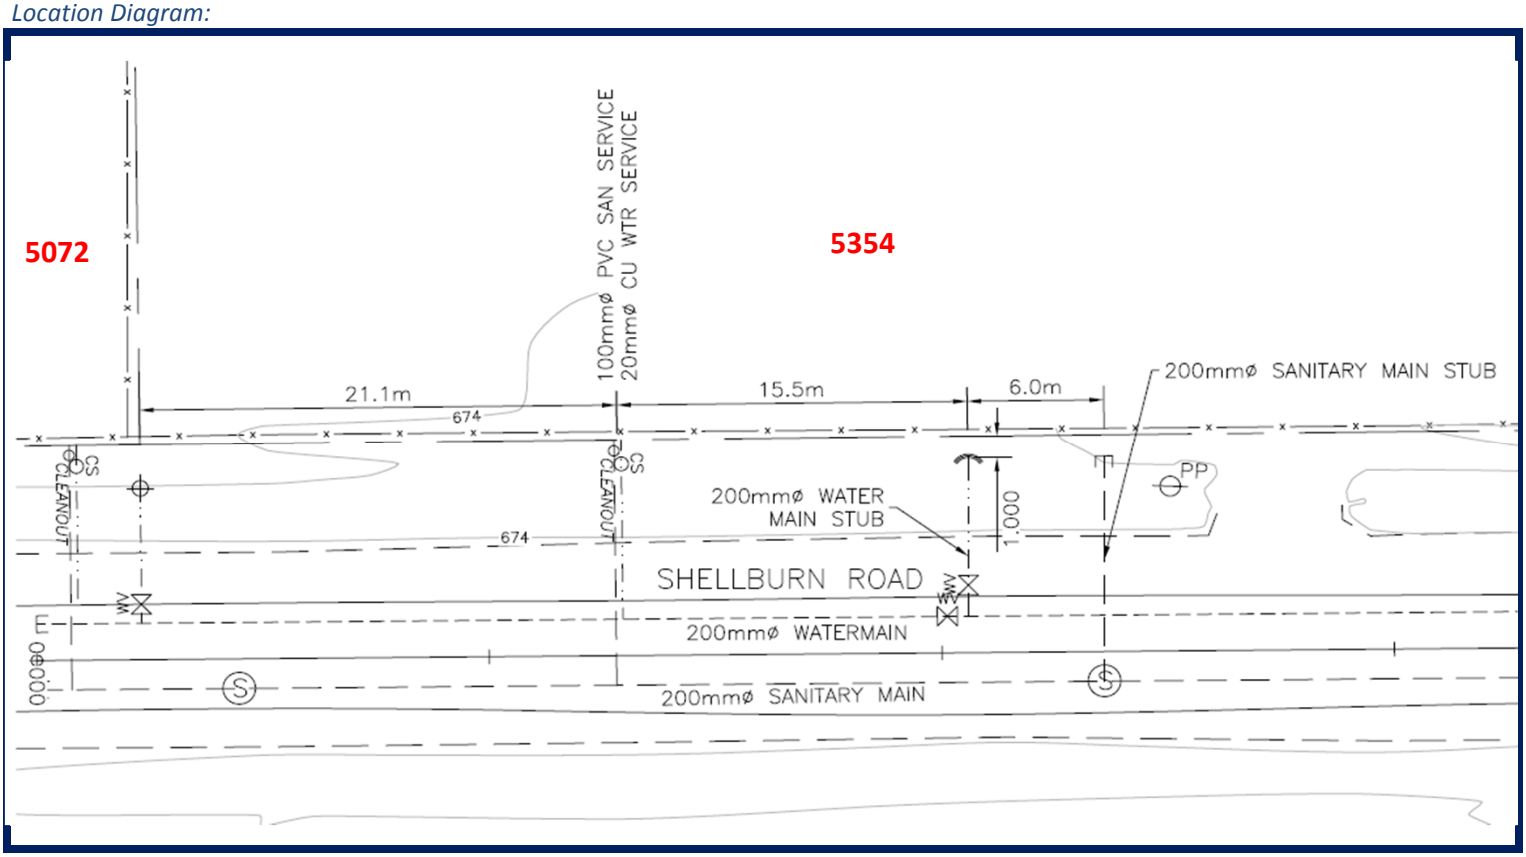
*Location Diagram:*