CITY OF
PRINCE GEORGE

City of Prince George
HISTORY SHEET

PID:	030-463-432
SD/MU:	SD100538
WO:	

CIVIC ADDRESS: 2700 Recplace Drive

LEGAL DESCRIPTION: 1 D.L.8180 EPP76632

SERVICE TYPE	DIAMETER (mm)	MATERIAL	INVERT ELEV AT MAIN (m)	INVERT ELEV AT PROPERTY LINE (m)	INVERT ELEV AT SERVICE END (m)	COVER AT PROPERTY LINE (m)	DISTANCE INTO PROPERTY (m)	INSTALLATION DATE
SANITARY 1	200mm	PVC	588.61	588.76	N/A	2.77	3.00	October 2015
SANITARY 2	200mm	PVC	589.42	589.65	N/A	2.24	N/A	August 2017
WATER 1	200mm	PVC	587.73	587.72	N/A	3.82	3.00	October 2015
WATER 2	200mm	PVC	587.89	587.90	N/A	3.62	N/A	October 2015

STORM IS ONSITE INFILTRATION

ELECTRICAL / COMMUNICATIONS / GAS			
TYPE	PROVIDER	SIZE AND MATERIAL	LOCATION (UNDERGROUND/ OVERHEAD)
ELECTRICAL	BC HYDRO	3x75mm DB2	UNDERGROUND
COMMUNICATION	TELUS	2x100mm DB2	UNDERGROUND
COMMUNICATION	SHAW	2x100mm DP2	UNDERGROUND
GAS	FORTISBC	114 PROP/P.E.	UNDERGROUND

INFORMATION SHEETS:	L&M ENGINEERING LIMITED PROJECT NUMBER 1502-01	SURVEY DATE:	SEPT_2017
INSTALLED BY:	R.F. KLEIN & SONS LTD (2015) AND DATOFF BROS CONSTRUCTION (2017)		
COMMENTS:	Municipal sanitary and water mains within unregistered SRW Plan EPP76633		

THE INFORMATION CONTAINED HEREIN IS FOR INTERNAL USE ONLY.
NOT TO BE RELIED UPON UNLESS CONFIRMED BY SITE INVESTIGATION.

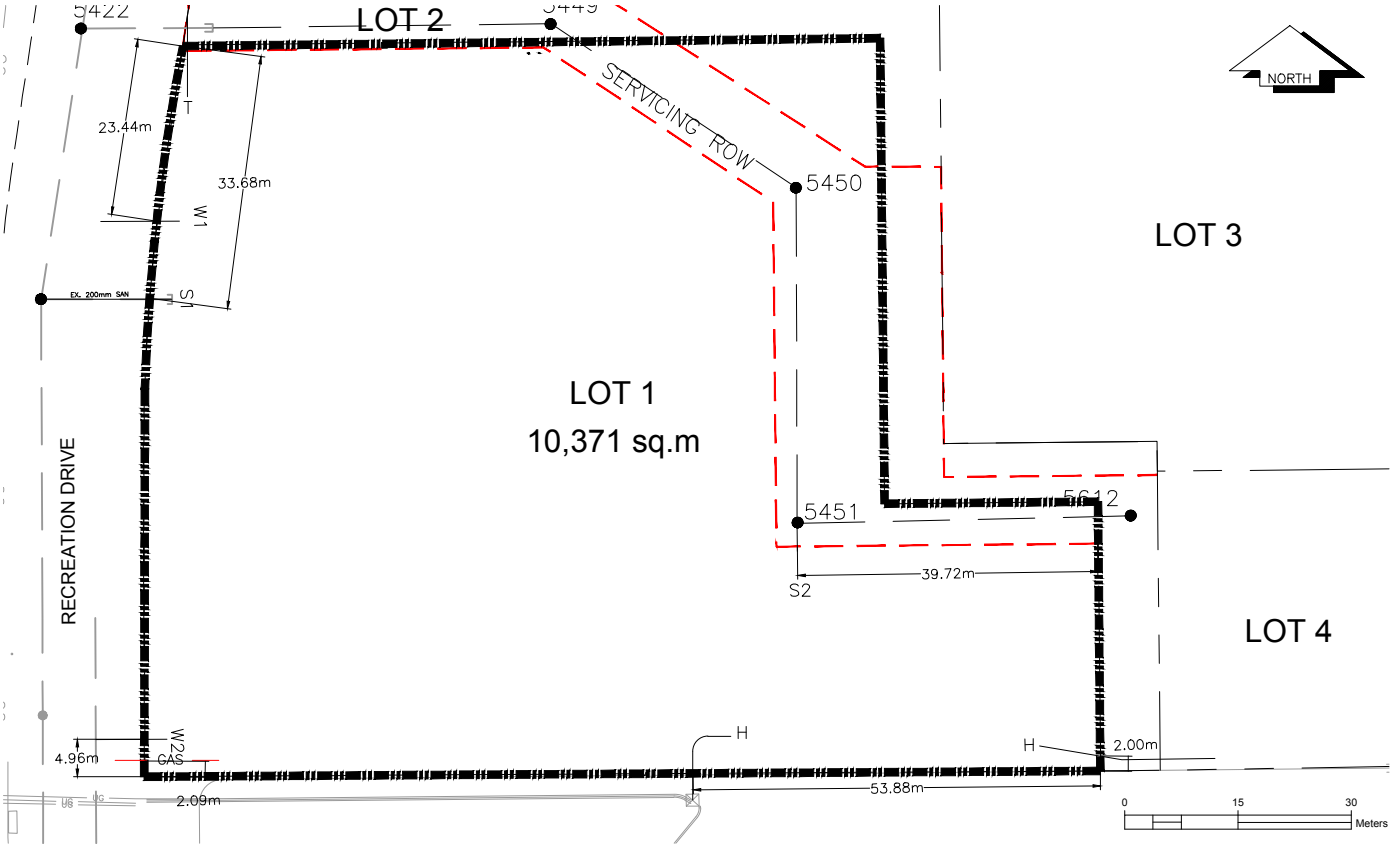

LEGEND:

CS	CURB STOP	W	WATER SERVICE	H	HYDRO SERVICE	GAS	GAS
CO	CLEAN OUT	D	STORM SERVICE	T	TELECOMMUNICATIONS	E	ELECTRICAL
		S	SANITARY SERVICE				