~~011824310~~
~~011824328~~
032565160

City of Prince George
HISTORY SHEET

SHEET NUMBER 5097 **Roll Number**

Legal: LOT'S ~~19 & 20~~ Parcel A BLOCK ~~294~~ 294 D.L. 343 PLAN 1268

Address: 585 17th AVE.

Sanitary Connection: # ~~117~~ SIZE MATERIAL INV. CONNECTED

Water Connection # 603 SIZE 3/4" MATERIAL Cu METER CONNECTED

Storm Connection: # SIZE MATERIAL INV. CONNECTED

Cash Receipt No's: WATER SANITARY STORM

CURB FROM PROPERTY LINE PAVEMENT WIDTH

B.C. HYDRO O.H. UNDERGROUND CONNECTION

B.C. TELEPHONE O.H. UNDERGROUND CONNECTION

INLAND GAS AS SHOWN.

Information Sheets:

Comments:
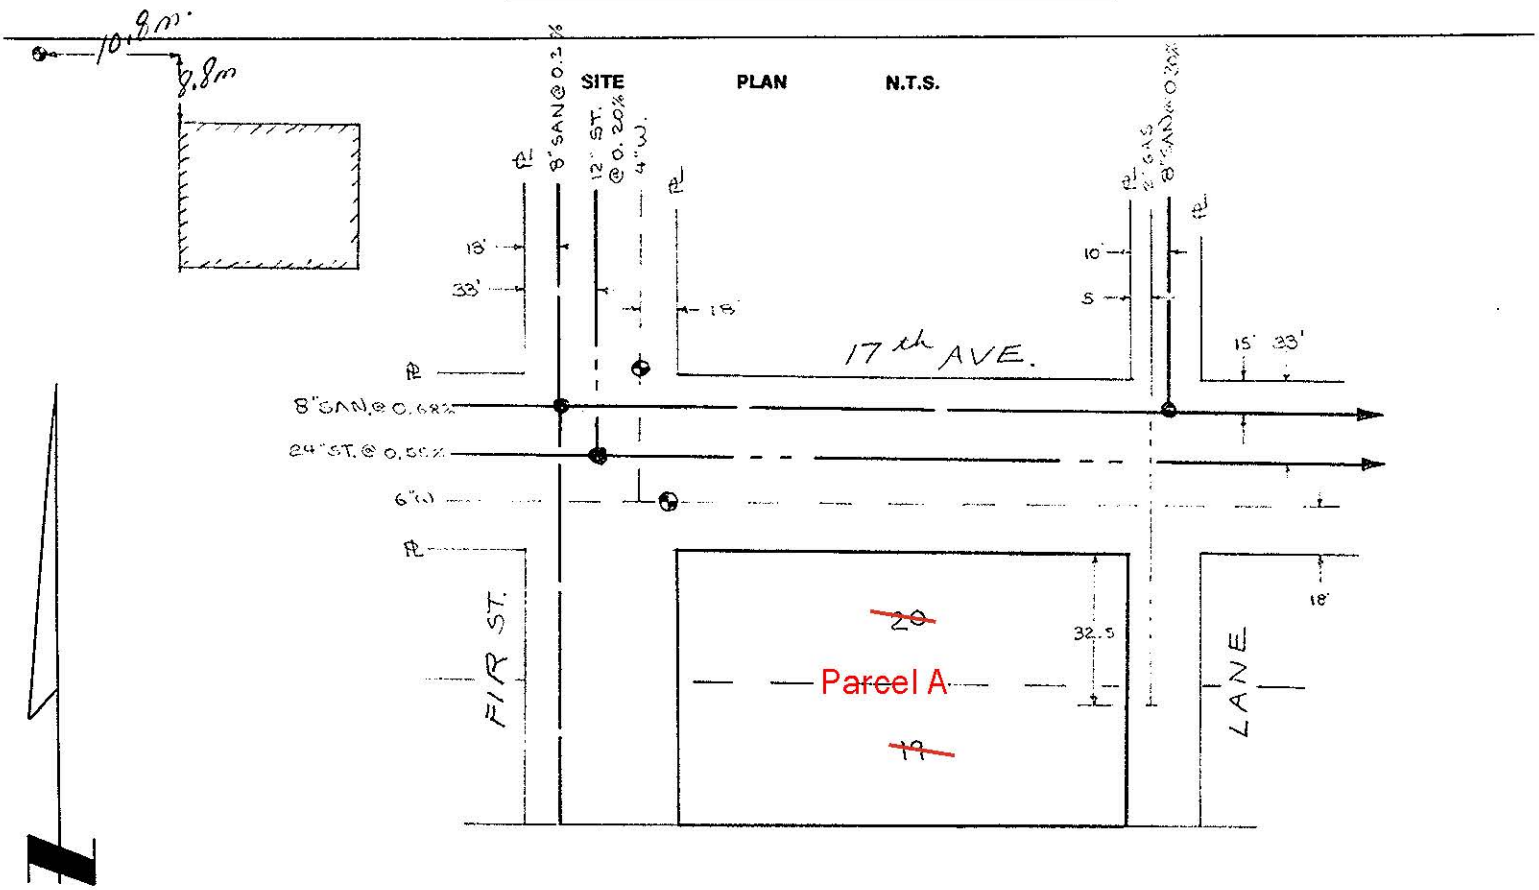
The City of Prince George does not represent or guarantee that the information contained in this document is accurate or reliable, and any person who relies on this information in this document does so at their own risk.