PERMITS & LICENCES

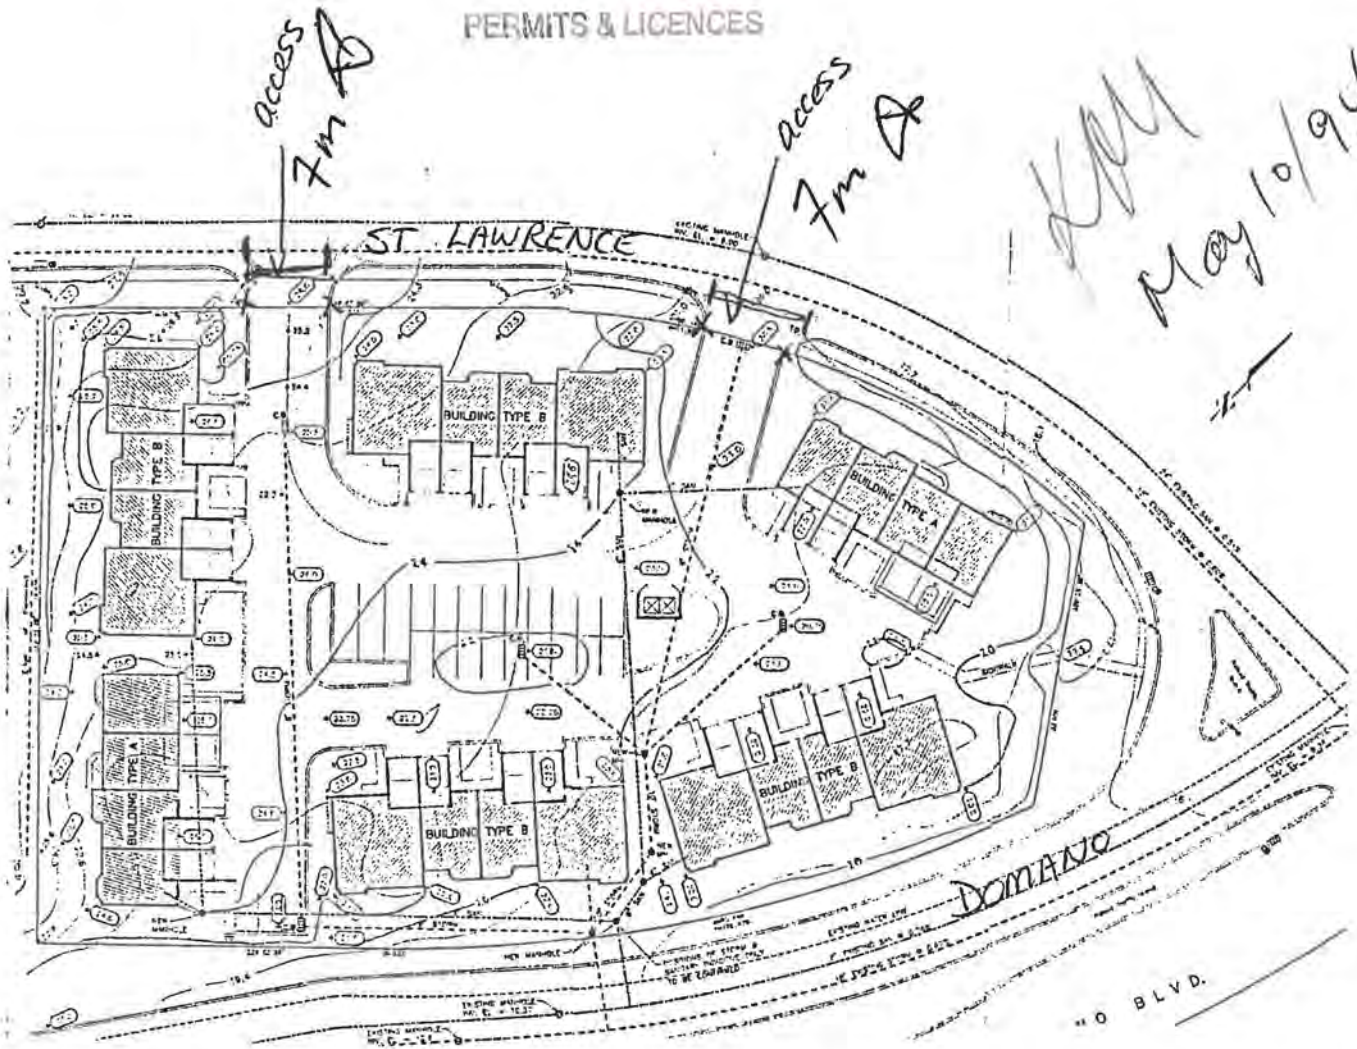

KPM
May 10/91