DS

City of Prince George
HISTORY SHEET

SHEET NUMBER **1374** **Roll Number** (PGS201)

Legal: LOT'S PCL 1 (13-19) BLOCK ~~160~~ D.L. 343 PLAN 38514

Address: 1624 6th AVE.

Sanitary Connection: # SIZE 150MM MATERIAL PVC INV. CONNECTED

Water Connection # SIZE 150MM MATERIAL PVC METER CONNECTED

Storm Connection: # – SIZE 250MM MATERIAL INV. CONNECTED

Cash Receipt No's: WATER 14542 SANITARY 14542 STORM 14542

CURB FROM PROPERTY LINE 4.877 m PAVEMENT WIDTH 10.363 m

B.C. HYDRO O/H UNDERGROUND CONNECTION

B.C. TELEPHONE O/H UNDERGROUND CONNECTION

INLAND GAS AS SHOWN IN LANE

THE INFORMATION CONTAINED HEREIN IS FOR INTERNAL USE ONLY. NOT TO BE RELIED UPON UNLESS CONFIRMED BY SITE INSPECTION AND/OR INVESTIGATION.

Information Sheets:

Comments:

SITE PLAN N.T.S.

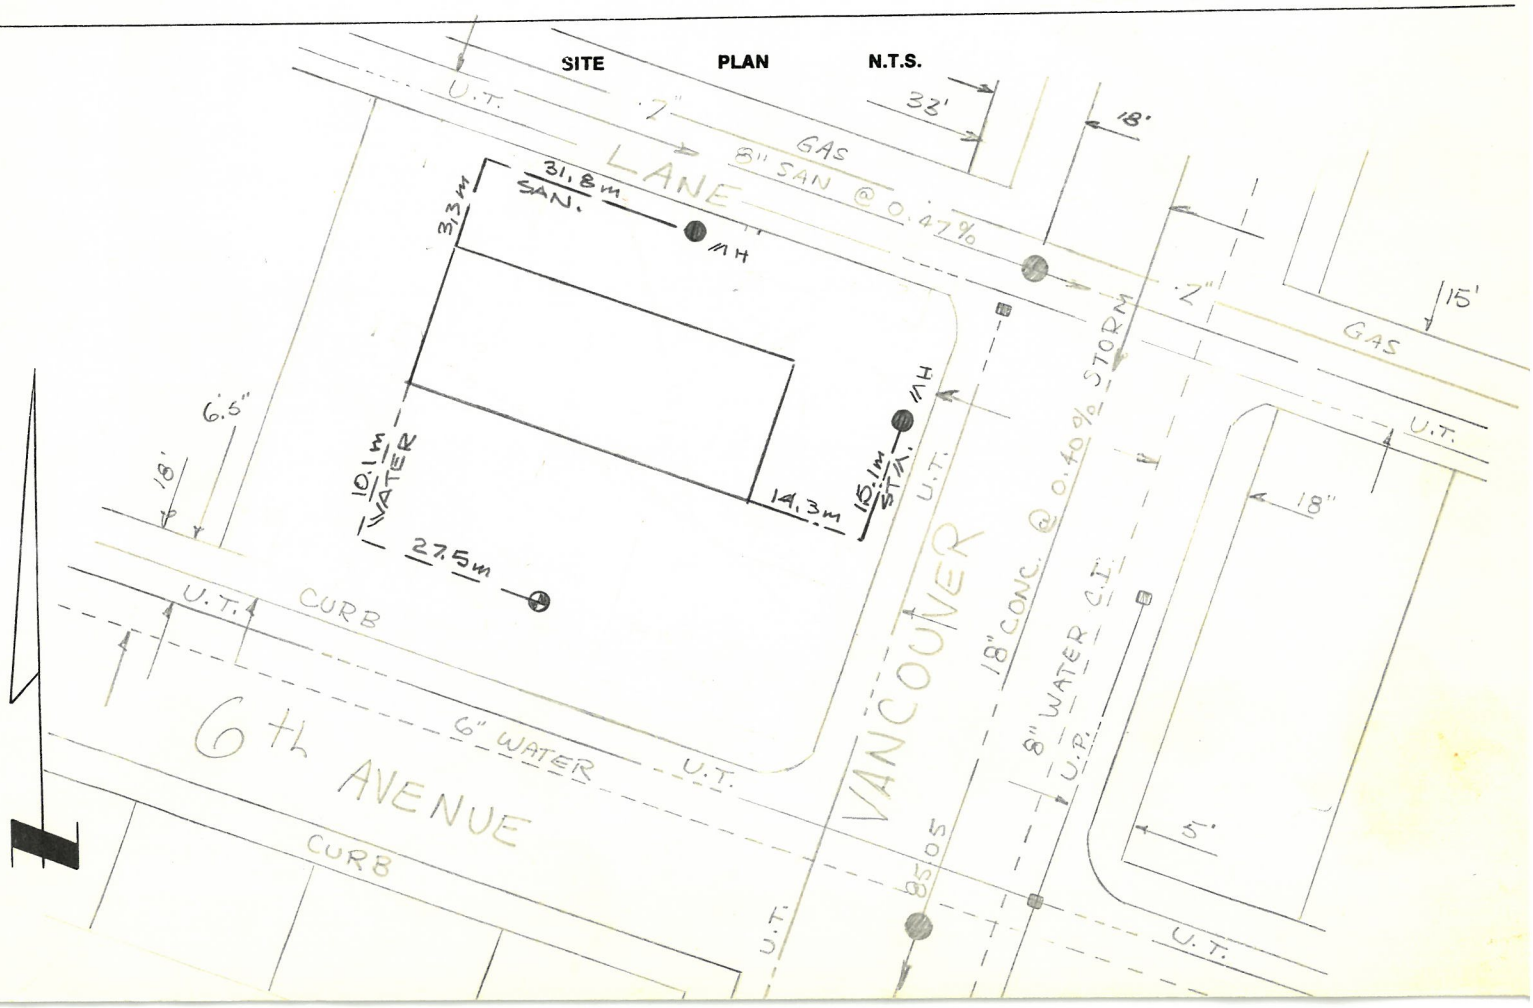

SANITARY & STORM INVERT CALCULATIONS	SANITARY		STORM
1. Distance from M.H. ..... to connection point is ..... ft. toward M.H.			
2. Calculated invert of main to conn. pt. is			
3. Main Size at connection point is ..... ins.			
4. Conn. invert at half diameter (Crown) of main is			
5. Add to (4) allowance of 0.2 for 1/8 bend. Adjusted invert now			
6. Dist. from main to P/L equals ..... ft. at ..... in/ft. gives rise of			
7. Item (5) plus (6) equals Calculated Elev. of conn. inv. at P/L equals			
13. Elev. of ref. hub top			
14. Elev. of invert at P/line			
15. Difference or cut below at property line			
16. Survey Date ..... 19 ..... Book Ref. ..... by			
17. Cut at P/Line in feet and inches			

Sanitary History:

SEPT. 27/94 FOR CONSTRUCTION REQ. BY: Allan [illegible]
OCT 31/94 - INSTALLED.

THE INFORMATION CONTAINED HEREIN IS FOR INTERNAL USE ONLY. NOT TO BE RELIED UPON UNLESS CONFIRMED BY SITE INSPECTION AND/OR INVESTIGATION.

Water History:

SEPT. 27/94 FOR CONSTRUCTION REQ. BY: Allan [illegible]
OCT. 3/94 - INSTALLED

Storm History:

SEPT. 27/94 FOR CONSTRUCTION REQ. BY: Allan [illegible]
OCT 4/94 - INSTALLED